for John Carpenter the Heirs

John Carpenter deceased
est ½ of the S. W. quarter
No. 4 of Range 1 E.
½ of N. W. qr. of Section 19
North and of Range No. 1 East
incipal Meridian
1840

of N. E. qr. and the West ½ of
t qr. of Sec. 24 of T. 4 of R. 1 West

N. E. qr. of Section 23 of T. No. 4 of
of the 4th principal Meridian
0.

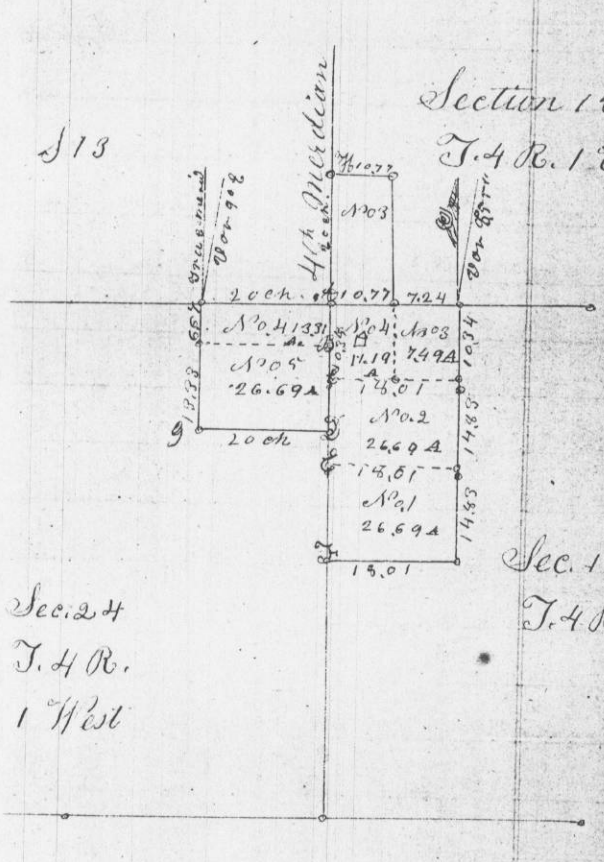

Concurrent Meridian

[illegible]