182

No. 295


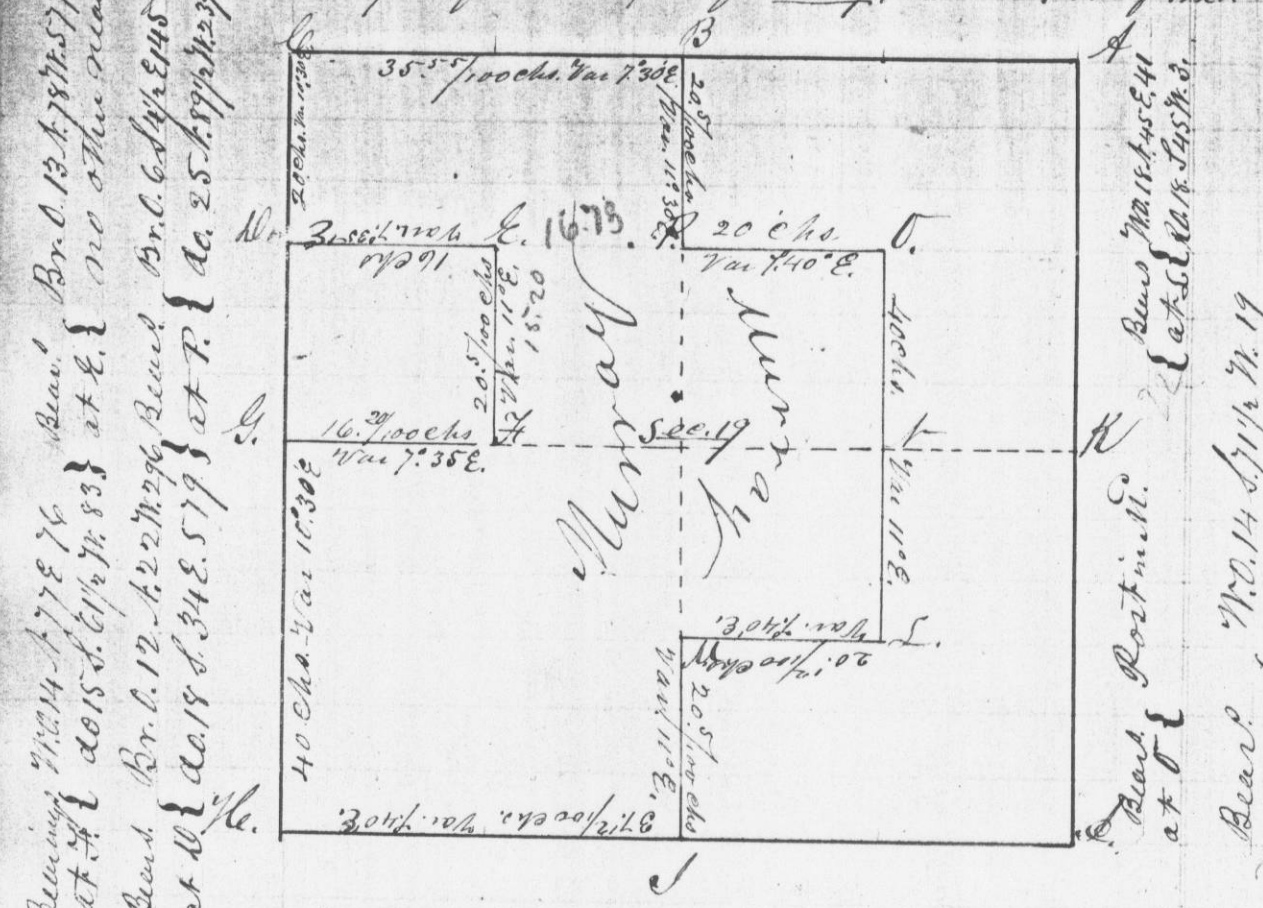

I hereby certify that the above is a true and correct representation of said survey, and statement of the minutes of the same as taken by me on the 16th and 18th days of Febry. A.D. 1846.

Chas. C. Witter
Dept. Dist. Surv. of
Grant Co. Wis.

37 12
35 55
1 57