184

No. 297.

Survey made for Chas. A. Murray, of the E½ of S.W.¼, Survey made for the E½ and N.E.¼ of S.E.¼ of Sec 17, T.4, R.4 W. of 4th P.M. G.L.

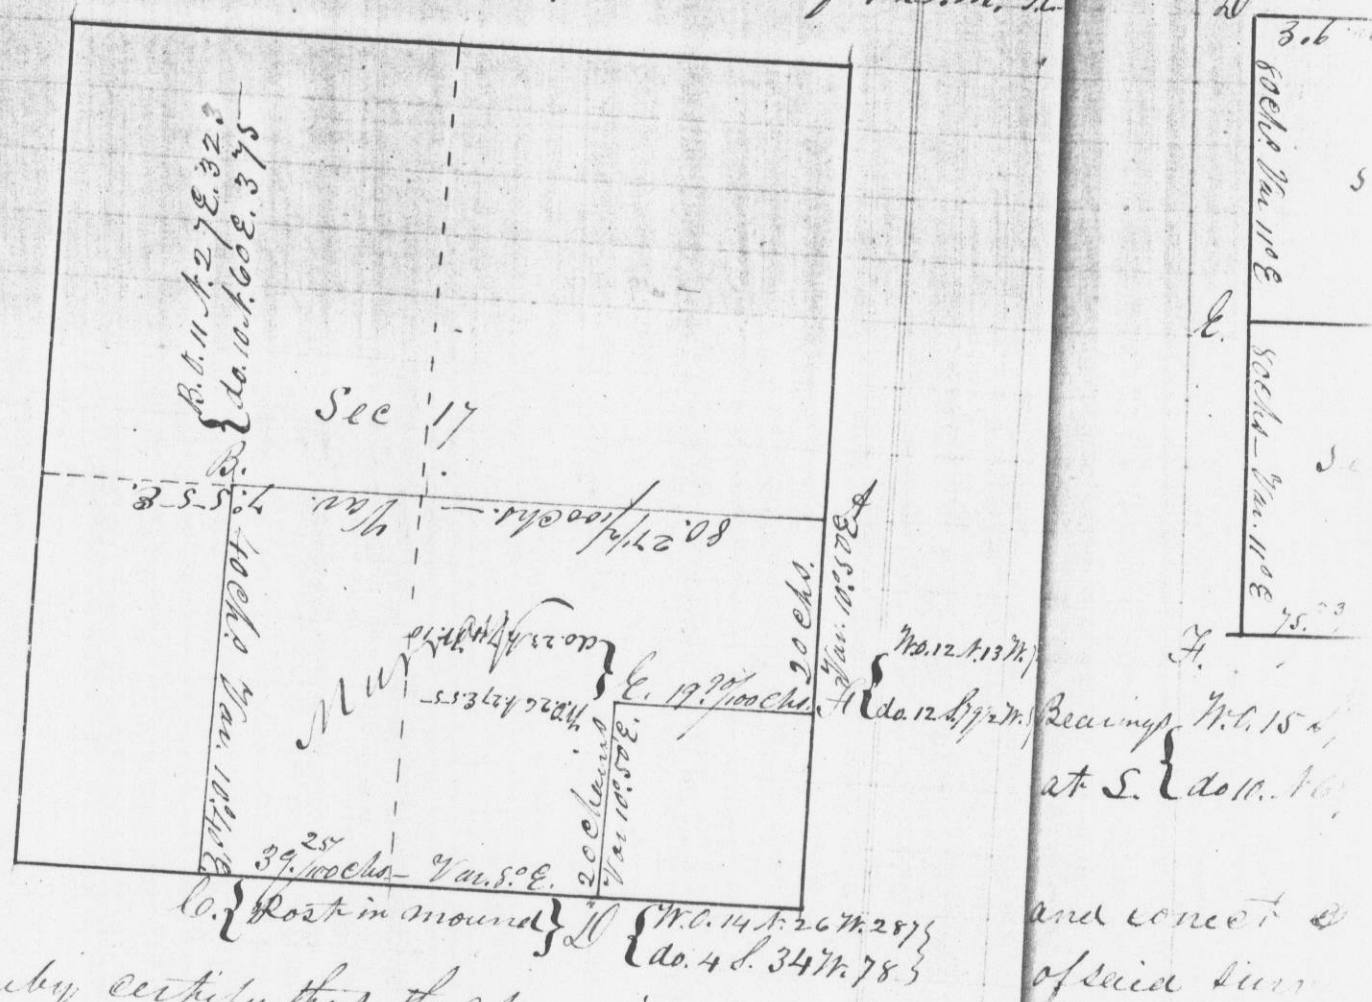

I hereby certify that the above is a true and correct representation and statement from the minutes of said survey, made by me on the 19th. day of February A.D. 1844

Saml. C. Walter
Deputy Dist. Surveyor
of Grant Co. W.T.