188

No. 301.

Survey made for Chas. A. Murray of the S.W. 1/4 and E. 1/2 of the N.E. 1/4 of Sec. 23, in T. 3 N. in Range 5 W. of 4th P.M. in Grant Co. W.T.

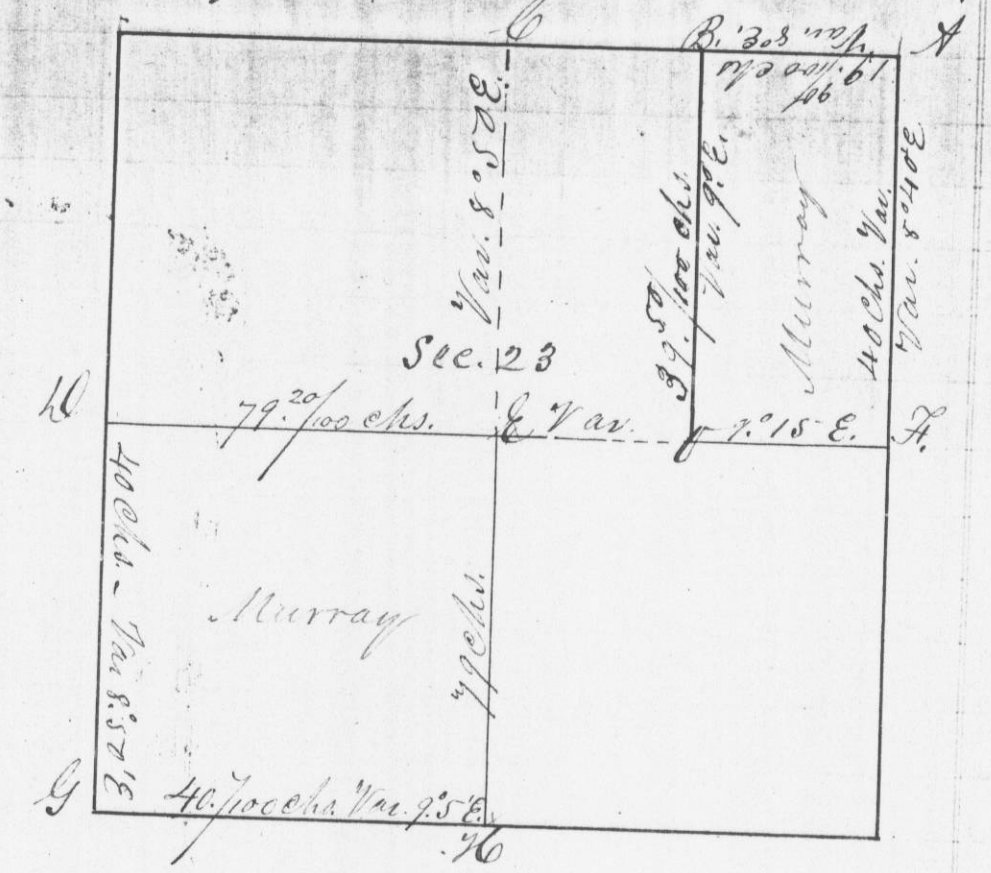

Bearings at E. { W.0. 30 S. 14 W. 104 / do 20 S. 23 E. 122 }

Bearings at B. { W.0. 20 N. 45 E. 105 / do. 10 S. 85 W. 62 }

Bearings at D { W.0. 15 N. 25 E. 18 / do 30 S. 65 E. 71 }

I hereby certify that the above is a true and correct representation and statement of the minutes of said survey made by me on the 26th. day of February A.D. 1844.

Saml. C. Wilts,
Dept. Dist. Sur.
of Grant Co. W.T.