Survey made for Robbert Templeton of the S E 1/4 of the S W 1/4 of Sect. 26 T 4 N R 5 W of the 4th P Mer

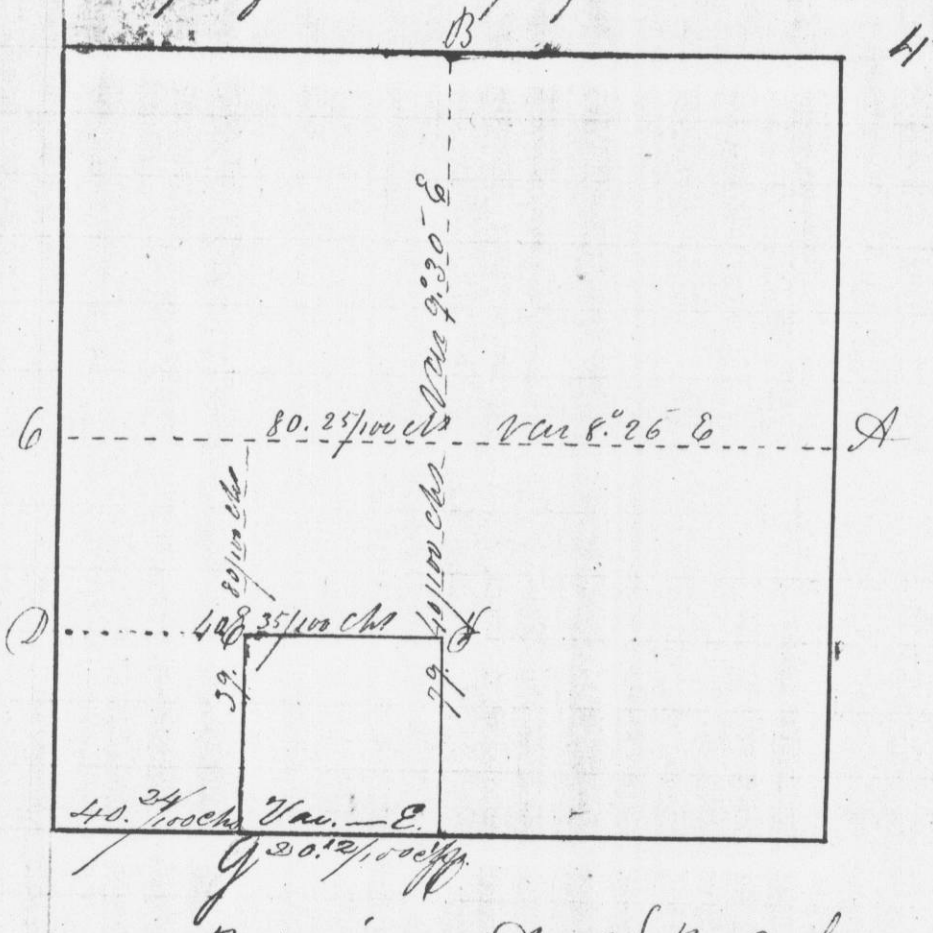

Bearings at B { Br Oak 18 N 41 E 212 lks
Maple 17 S 51 E 287 "

Bearings at G { Br Oak 24 N 19 1/2 E 106 "
Br " 18 N 19 1/2 W 146 "

Bearings at E. Br. Oak 16 N 2 1/2 E 166 lks

Corner at G Elm 12 S 43 E 34 lks

I hereby Certify that the above is a true plat & copy of the minutes of said survey made by me the 25th of February 1844

Saml. C. Miller
Dep. Surr. Surveyor
of Grand Co. M.T.

Beginning at the S W 1/4 of the S E 1/4 of the S W 1/4 of Sect. 26 T 4 N R 5 W 4th P M

Above is a minutes me the 28th
Saml. C. Miller
Dep. Surr. Surveyor
Grand Co. M.T.