No. 345

Survey made for Hercules L. Dousman of the N.W. 1/4 and S.W. 1/4 of N.E. 1/4 of Sec. 36, in Town 5 N. of Range of Range 3 West of the 4th P.M., W.T.

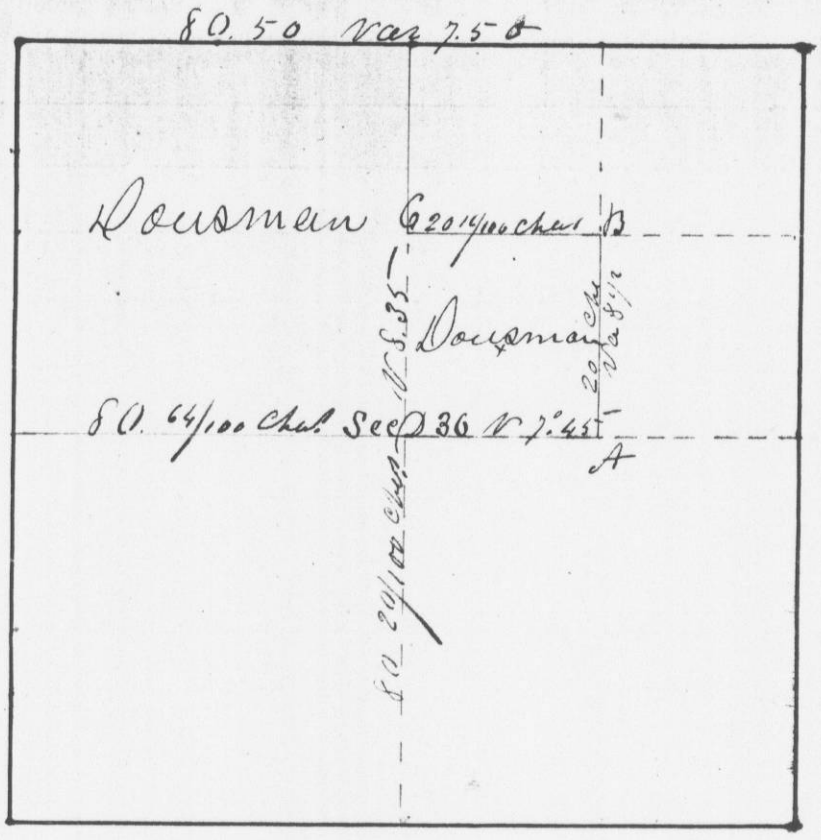

Survey made

N.E. 1/4 of

of the 4th P.M.

at A Post Cor { Br Oak 10 S 89 W 259 Lks.
" 4 S 85 E 184 "
at B Post Cor Jack 10 S 35 W 94 "
at C Post Cor { Br O 24 S 16 W 19 "
" 12 N 47 E 108 "
~~at D Br Oak 12 N 47 E~~
at D Jack 10 S 37 W 169

at C Post

Bearing

I hereby

certify

of Sur

I hereby Certify that the above is a true record of said Survey made by me the 6th of June 1844

Saml C Whitney
Dept. Dist Surveyor
of Grant Co W.T.