Survey made for J. M. Hopkins in T. 3 R. 3
to establish the quarter post from S to B at 3
which with its bearings had been destroyed by fire

Bearings { Br Oak 12 N 20 W 1.02
Br Oak 12 N 55 E 1.61

Geo. R. Stuntz
Dep't Dist Surveyor
G. C. W. T.

24-4-3 266A No. 381

Survey made for John Levitt
of the E ½ of the N. W. quarter of
Section 21 Town Six North Range
3 West of the 4th principal Meridian
Grant County W. T.

Bearings at
the corner
at A. W. Oak 10 N 74 W 54
10 " 6 W 5 E 2.67

B. Original

C Br Oak 9 S 82 E 32
9 " " 6 S 17 ½ E 37

D Br. Oak 10 N 19 E 82
10 " 6 N 84 W 18

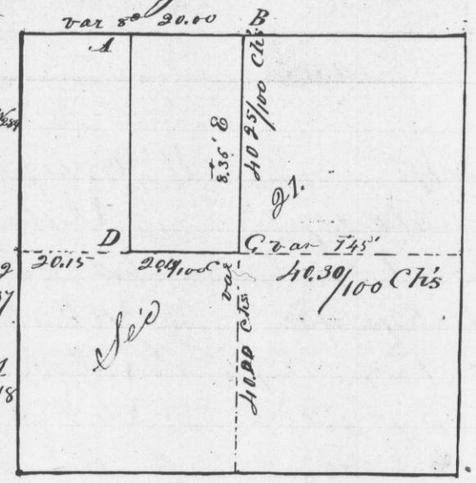

I hereby certify that the above is a true record
of the plot and minutes of said Survey made
by me June 7th 1845

Geo. R. Stuntz
Dep't Dist Surveyor
G. C. W. T.

Survey of a mineral lot for Simpson Ordwaine
in Section 34 Town 3. North Range 3 West of the
4th principal Meridian Grant County W. T.
June 11 & 12th 1845

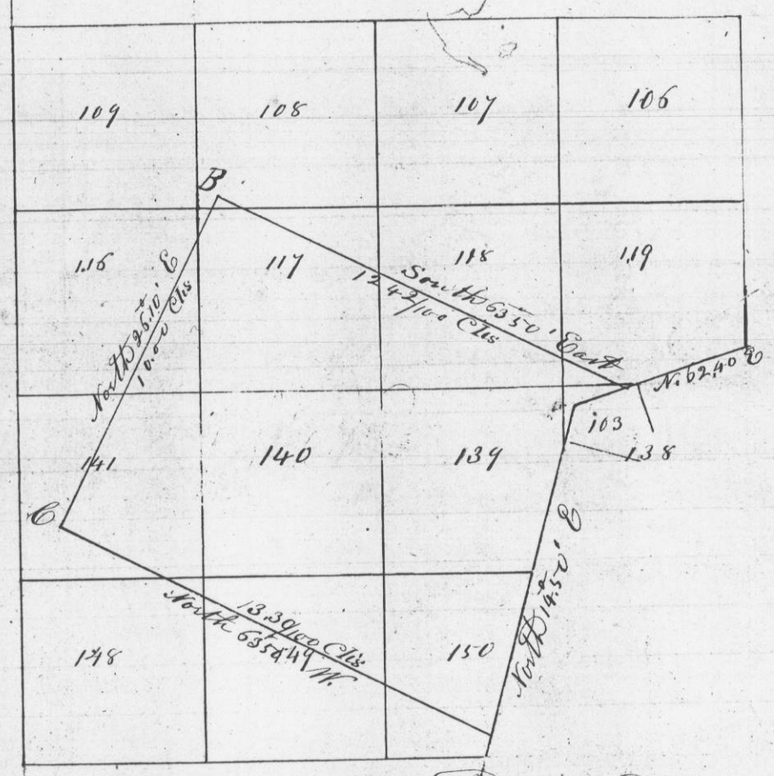

Commencing on the West side of lot 81
in the Town of Potosi 45 links N. of the S. W. Cor
Then running North 63 50' West 13.30/100 Chs
To a stone corner. Bearings { Elm 9 N 34 ½ W 33
B. Oak 15 N 75 E 15½

Then North 26 10' E 10.00 Chs Then South 63 50' E
12.42/100 Chs to the North side of lot 103 40 links
N. from the North East corner
Bearing at B. B. Oak stump 30 S. 77 W 26
I hereby certify that the above is a true
record of the plot and minutes of said
Survey made by me as afore said Geo. R. Stuntz
Dep't Dist Surveyor G. C. W. T.