No 399

Survey made for Augustus Cunrade of a mineral lot. Commencing at the ¼ post in the center of Section 30 Town 4 N. Range 4 West of the 4th Principal Meridian Grant County W.T.

Thence West	(var 8.40' E)	10.	Chns to cor. B.O. s.180 E.
Thence North	(var 11.05' E)	10.	..to cor. B.Oak 183 E
" West	(" 8.40' ")	10	...
" North	(" 11.05' ")	10	...
" East	(" 8.40' ")	20	...
" South	(" 11.05' ")	10	... B.Oak 1.85 E
" East	(" 8.40' ")	10	...
" South	(" 11.05' ")	5.43	..(Ironwood 5. N 70 W 17
" North 70° W	(" 11.05 ")	10.67	...
" South	(" " ")	8.00	..to place of beginning

Being Lots 1, 2 & 4 in S.E. ¼ of N.W. ¼ of said Sec and part of Lot in S.W. ¼ of N.E. ¼

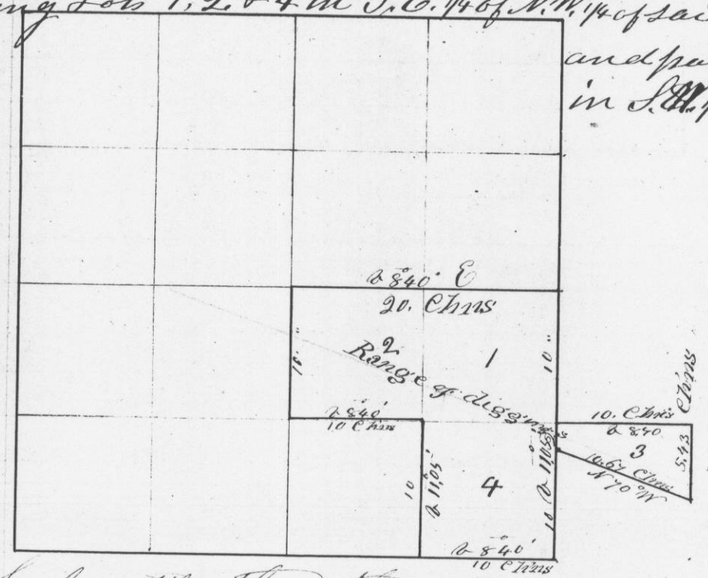

I hereby certify that the above is a true record of the plat and minutes of said Survey made by me July 31st A.D. 1845

Geo. R. Stuntz
Dept. Dist. Surveyor
G.C. W.T.

No 400

Survey made for Lawrence Goodman of the S.E. ¼ of the N.W. ¼ & the N.E. ¼ of the S.W. ¼ of Section 20 Town No 3 North of Range No 3 W. of the 4th P.M. Commencing at the ¼ post on the N. side of said Section; Thence South variation 9.30' E

80.50/100 Chns Intersect 1.66 links E of post

Corrected back variation 8.18'

East through the center of Section; variation 8.45' E

79.85 Intersect ~~¼ post~~ .40 links N. of ¼ post on E side West corrected variation 8.27'

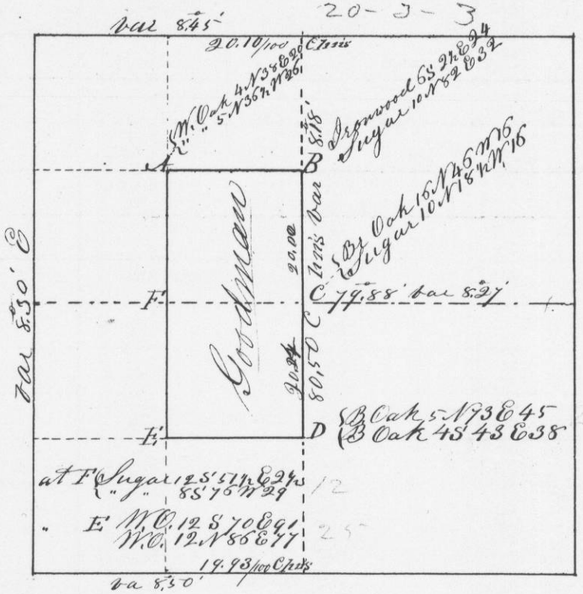

I hereby certify that the above is a true record of the plat and original field notes of said Survey made by me August 25 & 26 A.D. 1845

Geo. R. Stuntz
Dept. Dist. Surveyor
for Grant County W.T.