Survey made for John H. Rountree of the South East quarter of Section No. 26 in Town No. 4 North of Range No. 1 West of the 4th principal meridian in Grand County W.T. February 14th 1846

Section No. 26 in Town No. 4 North of R 1 W

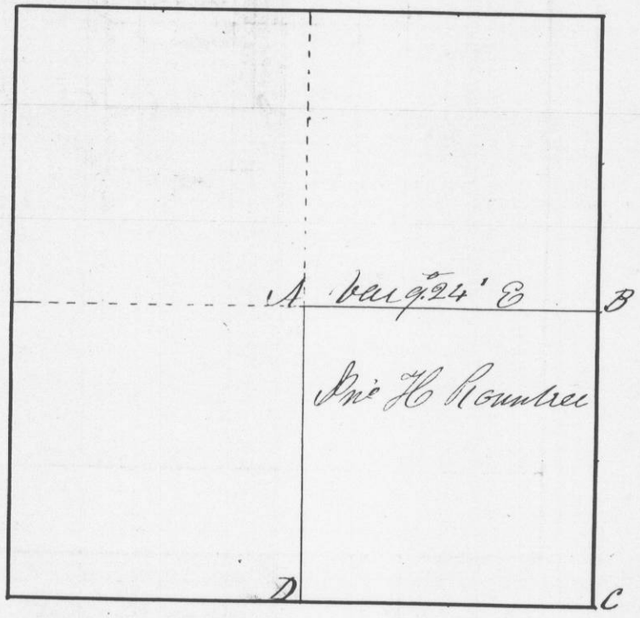

Bearings at the corners

at A {W. Oak 15 N 22½° E 130 links
W. Oak 15 S 78½ E 103 links} 9

at B. {W. Oak 17 S 53½ E 53 links
R Oak 14 N 50 W 23 links} Original

at C {Be Oak 18 N 63 W 33 links
Be Oak 24 S 36½° W 37 links} Original

at D Be Oak 8 N 68½ E 166 links
B Ash 8 N 89½ E 175 links} Original

I hereby certify that the above is a true plat and correct minutes of said survey made by me this fourteenth day of Feb 1846

Survey made for Saml R. Beard of the N E 1/4 of the N W 1/4. The S W 1/4 of the N E 1/4 & the W 1/2 of the S E 1/4 of Section 22. in Town 4 N of Range 4 W of the 4th Prime Merid-

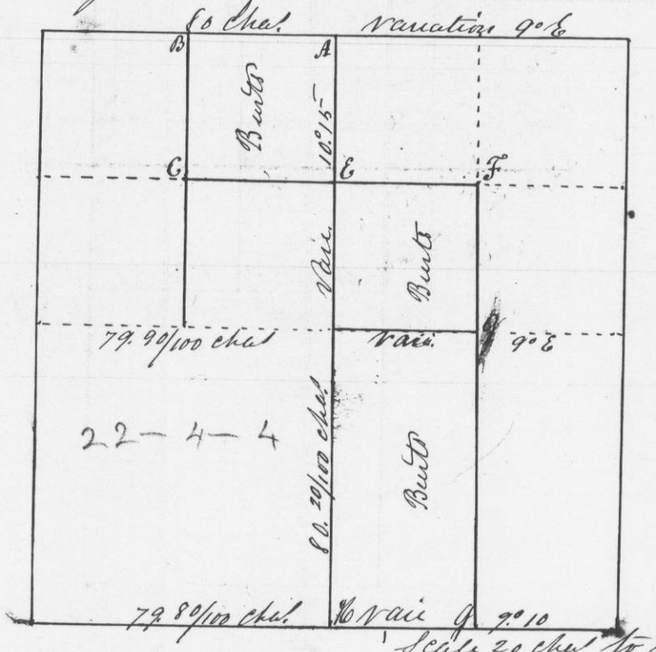

AA	A	Post Cor.	Bur Oak 28 N 32½ E	938 Lks.	Original
10	" B	" "	Set in Mound of Earth		
14	" C	" "	Bur Oak 12 S 30 E	121 Lks	
11	" E	" "	" " 10 N 16 E	24 "	
18	" F	" "	" " 25 N 72 W	275 "	
17	" G	" "	{ W Oak 40 N 71 E	41 "	
			" 10 N 68 W	75 "	
7	" H	" "	" 16 S 32 W	51 "	

I hereby certify that the above is a true plat and copy of the minutes of said survey made by me the 2d day of February 1846 Saml C. Weed Surveyor