No. 453

Survey made for Daniel Rise of the W 1/2 of the S W 1/4 & the W 1/2 of the S E of the S W 1/4 of Sect 21 in Town 2 N of R 1 West of the 4th Princ. Meridian 21—2—1

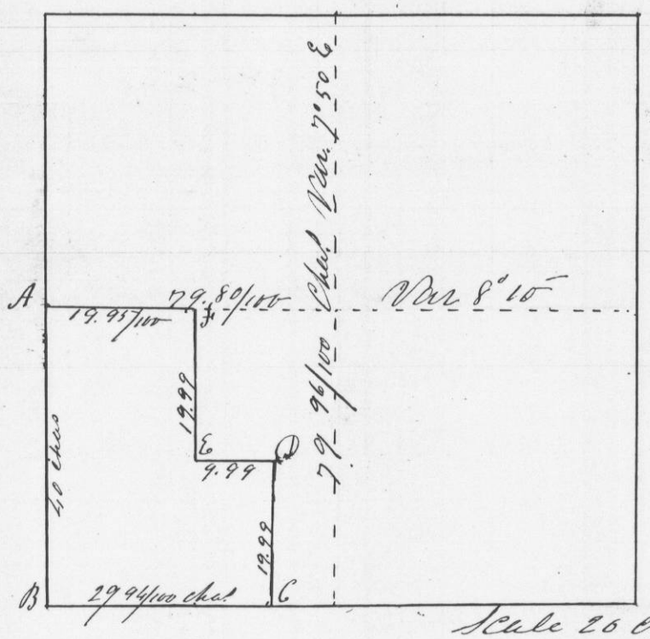

Scale 20 chas to the inch

At A Pat Cor { Black Oak 10 S 84 W 204 lks
" " 6 N 28 W 198 "

At B " " { Bur Oak 14 S 42 E 35 "
" " 10 N 13 W 66 "

12 Rock

C. D. F Rock corners

I here by certify that the above is a true copy of the minutes of said Survey made by me the 6th day of May 1846

Samuel C Willey
Dist Surveyor of
Pt Co W. T. M.

No. 454

Survey for John Bennet of the N 1/2 of the N W 1/4 of Sect. 28 in Town 2 N of Range one W of the 4th Princ. Merid.

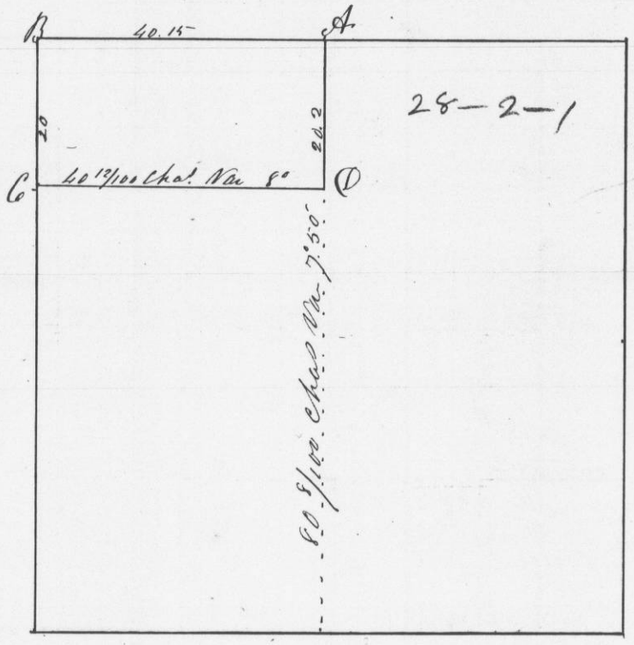

Scal 20 chas to the inch

At A Pat Cor Original Barings destroyed

At B " " { Bur Oak 14 S 42 E 35 lks
" " 10 N 13 W 66 " New

13 + 11 " C & D Rocks set for corners

I hereby certify that the above is a true Plat & copy of the minutes of said Survey made by me on the 6th day of May 1846

Samuel C Willey
Dist Surveyor of
Pt Co W. T. M.