№ 477

Survey made for Henry Dean, Evalzus Rufell Philo Dempsey and Silas Walker in section № 13 in Town № 6 North of Range № 3 West of the 4th Meridian in Grant County Wy April 24th 1847

Section 13 Town 6 Range 3 West

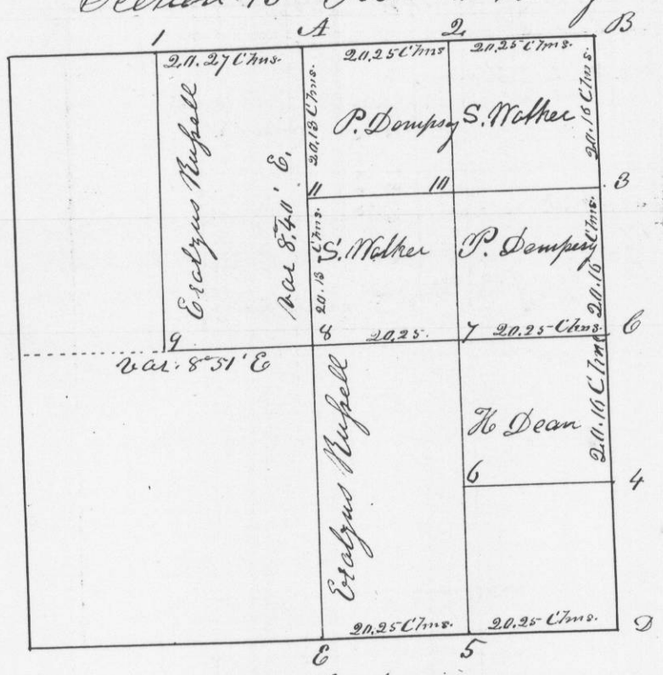


Corners established

At 1. { Br Oak 14 S 7° W 95 links
10 Br Oak 15 S 34 E 34 E

" 2 { White Oak 12 S 42° W 33 links
15 Br Oak 6 S 63° E 27 links

" 3 W Oak 12 N 76 E 45 links
16 Br Oak 8 N 71½ W 29 links

" 4 Set post in mound.

" 5 Set post in mound

at C. Set post in mound

" 7 { White Oak 24 S 40 E 100 links
17 White Oak 24 N 46½ W 93 links

" 8 { W. Oak 12 N 2½ E 52 links
9 W. Oak 12 S 35° E 765 links

" 9 { W. Oak 20 S 76° E 79 links
12 W. Oak 10 N 85½ W 114 links

11 { Black Oak 8 N 14 W 38 links
White Oak 15 N 32 E 58 links

11 { White Oak 10 N 44 W 22½ links
White Oak 12 S 12 E 54 links

I hereby certify that the above is a true plot and correct minutes of said survey made by me the 24th day of April A.D. 1847 Geo R Stumbz
District Surveyor G.C.W.T.



№ 478

Survey made for Burton R. Grubb of the West half and North East quarter of the North East quarter of section № 17 in Township № 1 North of Range № 1 West of the 4th Meridian in Grant County

Section № 17 T. 1 R. 1.

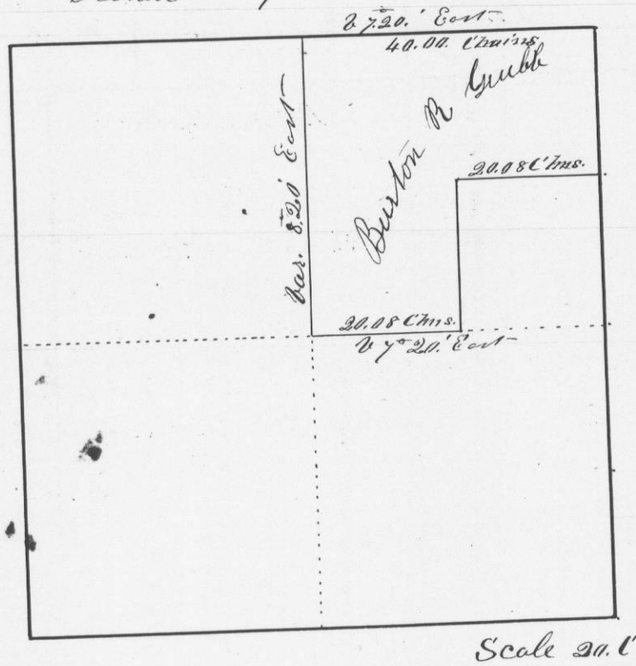


Scale 20 Chains to the inch

I hereby certify that the above is a true plot and correct minutes of said survey made by me the twenty ninth day of April A.D. 1847

A true Record Attest.

Geo R Stumbz
District Surveyor of
Grant County Wty.