No 507

Survey made for Abraham Mehaffey of the W½ of S.W¼ of Sec - 32 T4-R1 west of the 4th Principal Meridian in Grant County W.T.

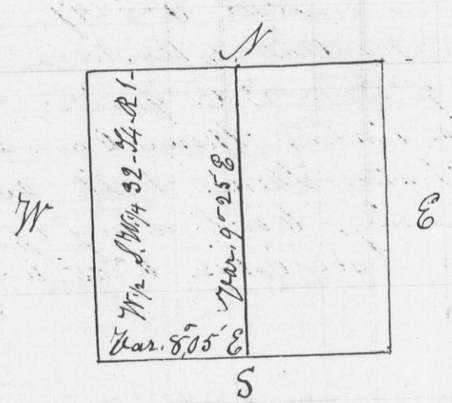

Commencing at Corner of Sections 31 & 32 on Town line

Thence East 20.16 chains	Lynn	10	N 54°	W	1.28	links
	B. oak	5	"	E	.72	
North 40.42 chains	W. Elm	17	S	20 W	.94	
	Elm	11	N	19½ "	.52	

West 20.25 chains to ¼ Post on west side of section } Original
South to beginning

I hereby certify that the above is a correct & true record of Survey made by me this 12th day of August 1847

Geo. R. Stuntz
District Surveyor G.C. W.T.
By Stephen Mahood
Deputy

No. 508

Survey made for James Gillmore of a small lot in Section No. 1 in Township No. 1 North of Range No. 2 West of the 4th principal Meridian

Sept 11th 1847

Commencing 650 links East of the North West Corner of the East ½ of the S.E. quarter of Section one Thence North 200 links, Thence East 250 links Thence South 200 links, Thence West 250 links to the place of beginning, Containing 5/10 of an acre

Variation 6° 15' East

A true record of the Field notes of Said Survey Attest Geo. R. Stuntz
Dist Surveyor of
Grant Co. Wis.