No. 515

Survey made for Nicholas Tormey of the East half of the N.W. quarter of Section No. 2 and the North West quarter of N.E. quarter of same Section

Corners all established by running as the law directs from quarter post to quarter post

Sec. N.2. T. 5. R. 2. West.

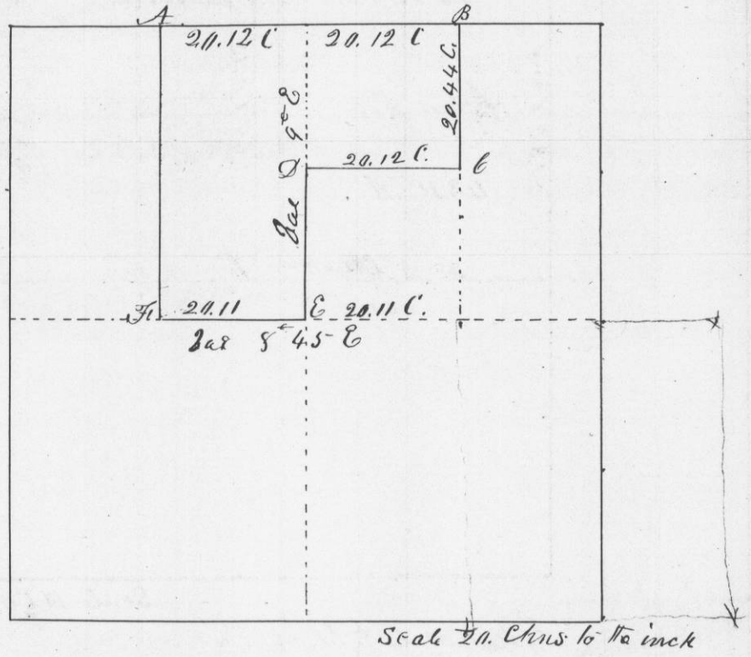

Scale 20 Chns to ¼ inch

Corners established

at A. set post

at B set post — Bearings { Bur Oak 14 S 40° W. 60 Links / White Oak 12 S 38½ E 44 Links

at C set post — Bearings { Willow 4 North 2 Links

at D set post — " { Bur Oak 83.71° E 118 Links

at E Set post — " { Bur Oak 108 S 42½ E 41 / Black Oak 108 80 W 144

at F set post —

I hereby certify that the above is a true plat and correct Mins. notes of said survey made by me the third day of December 1847 Geo. R. Stuntz — District Surveyor G.L. Wis

No. 516

Survey made for A. Locadbelle of the West half of the South West quarter and the South West quarter of the North West quarter of Section No. 24 in Township No. 6 North of Range No. 1 West of the 4th principal Meridian Dec. 4th 1847

Corners all established by running from quarter post to quarter post as the Law directs

Sec. 24. T. 6. N. 1. W.

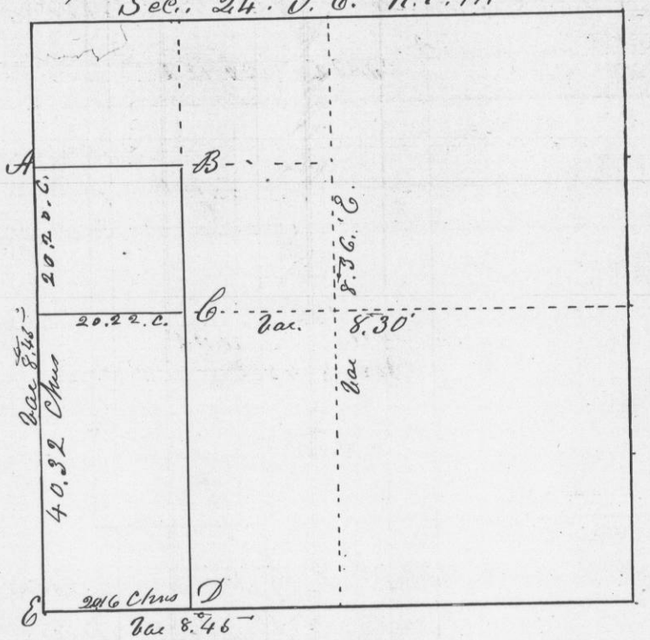

at A. — Bearings { White Oak 8 N 31° E 27 Links / 13 / White Oak 9 S 77 W 40 Links

at B " 14 { Bur Oak 8 S 77 W 38 Links / White Oak 6 N 86 E 72 Links

at C " 12 { White Oak 8 N 54 W 2 Links / White Oak 6 N 52 E 10 Links

at D " 23 { Black Oak 6 S 74° E 348 Links / Black Oak 4 S 86° W 27 Links

at E original " I hereby certify that the above is a true record of the plat and minutes of said survey

Geo R Stuntz
District Surveyor of
G.L. Wis.