No. 519

Survey made for Michael & Joshua Woodward of the North West quarter of the North West quarter of Section No. 13 in Township No Six North of Range No. three West of the 4 th principal Meridian

December 17th 1847

Corners established by running as the law directs –

N. W. quarter of N.W. quarter of Sec. 13 T6 R3

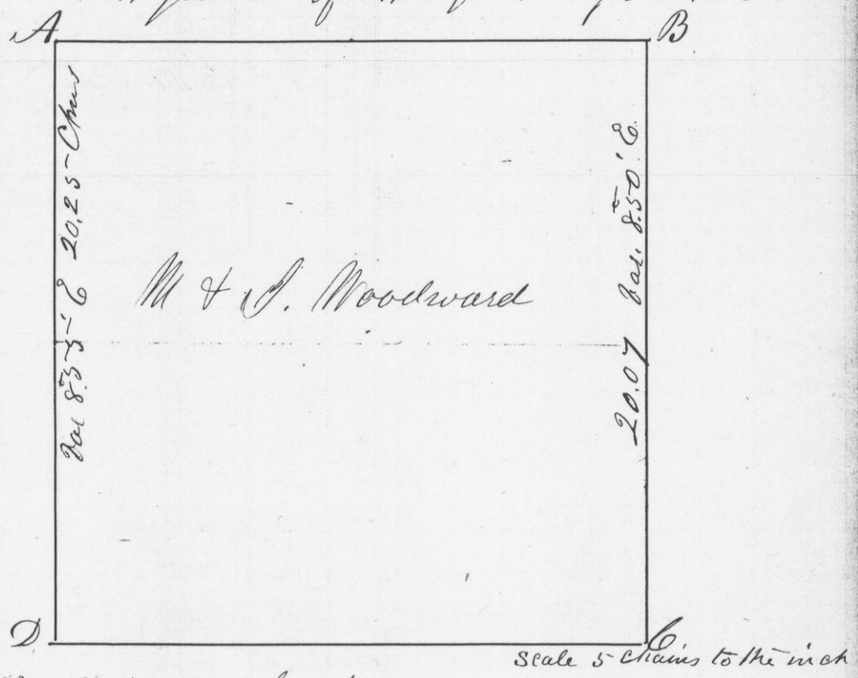

at A Original bearings
at B " set for Pickpelles N W corner
at C 14 { White Oak 18 S. 39° W 39 links
White Oak 16 S 38½ W 39 links
at D. 13 { White Oak 12 S 88½ E 50 links
White Oak 10 S 68½ W 49 links

I hereby certify that the above is a true record of said Survey

Geo. R. Stuntz
Dist. Surveyor G.C.

No. 520

Survey made for P. F. Dillon of the N.W¼ of the S.W¼ of Section 6. T4. R3 West of the 4th Principal Meridian in Grant County W.T.

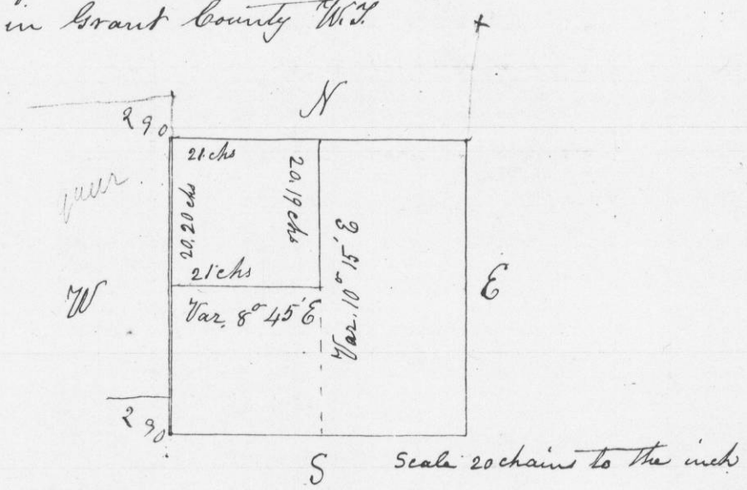

Commencing at the ¼ Sec Post on Range line
8 B. Oak 7 S 8½ W 4.64 links. Being the bearing to ¼ Post to Sec-1. T4. R4
12 East 21 chains to 1/8 Post Double B. O. 10 N 47° W 1.64 } links
No other near
25 South 20.19 chains to 1/16 Post B. O. 10 N 1° E 1.80 } "
B. O 4 " 48 W 1.50 }
24 West 21 chains to 1/16 Post B. O. 11 S 63 E 7½ }
W. O 11 N 33 " 46 } "

North 20.20 chains to the place of beginning

I hereby certify that the above is a correct record of Survey made by me August 31st 1847

Geo. R. Stuntz
District Surveyor G. C. W. T.

By Stephen Mahood
Deputy