No. 529

Survey made for A. & G. F. Clifton of the N.W.¼ of S.E.¼ of Section No. 5 - T5 N. of R 1 west of the 4th Principal Meridian

S. E.¼ of Section 5. T5 - R 1 W

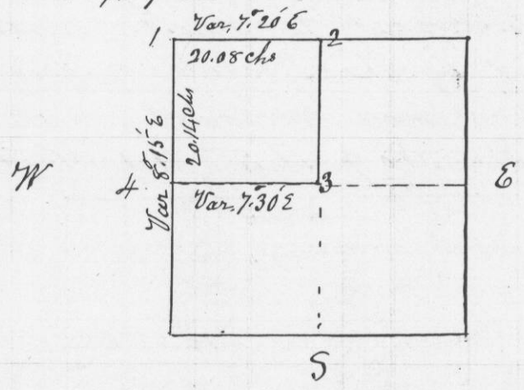

Commencing at quarter post in Centre of Section at 1
~~Bearings~~ Willow S. 5. 58° E 67 links - no other
Thence East 20.08 chains set stake at 2 -
Thence South to 3 Bearings { White oak 14 S 34° W 1.29 } links
{ Br oak 8 N 9½ " 55 }
Thence West to 4 " { Br. O. 9 S 88½ W 2.91 } links
Thence North 20.14 chains to the place of Beginning

I hereby certify that the above is a true record of Survey made by me Feby 12th 1848

Geo. R. Stunty
District Surveyor
G. C. Wis Ty.

No. 530

Survey made for Henry Thiers of west half of the S.E.¼ of Section No. 35 in Township No. 3 N. of R No. 2 west of the 4th principal Meridian

S. E.¼ of Sec - 35 - T3 - R2 -

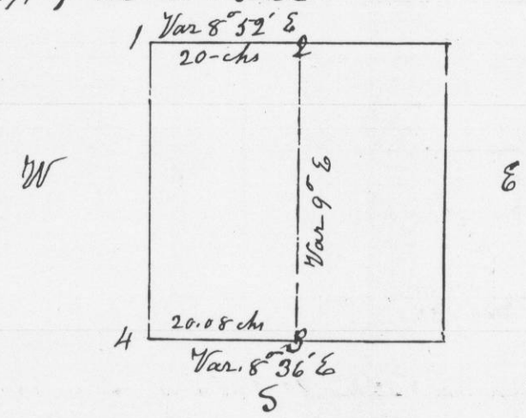

Commencing at S.E. corner of Section Thence West 40.16 chains Var. 8° 30' E intersected 7 links South of ¼ Post.
Thence North through centre of Section intersected at Post { Var 9° E }
East through centre of Section Var 8.25 E intersected 67 links north - Corrected back to centre Var 8° 52' E --
Bearings at 1 - ¼ Post in Centre of Section
White oak 18 N 5° E 66 links - no other -
Thence East - to 2 = 20 - chains - Bearings { W. O. 14 N 41° W 37 } links
{ Sugar 10 S 71 " 21 }
Thence South to 3 - W. O. 20 S 77 E 17 } links
Sugar 8 N 31 " 25 }
Thence West to 4 - Original Corner
Thence North to the place of beginning

I hereby certify that the above is a true plat and record of the minutes said survey made by me Feb. 15th 1848

Geo. R. Stunty -
District Surveyor
G. C. Wis. Ty.