40.12.
40.72
80.44

No 539

Survey made for Francis Tebo of the S.W¼ of the S.E¼ and the S.E¼ of the S.W¼ of Section 14-T4-R4 west of the 4th Principal Meridian in Grant County W.T.

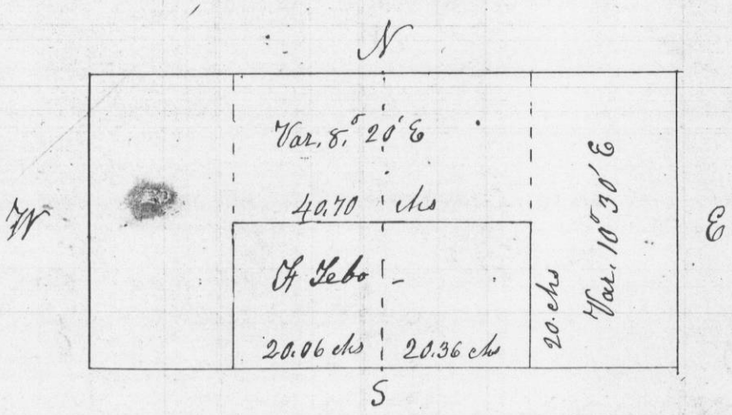

Commencing at the ¼ Post between Sections 14 & 23-T4-R4
Thence East 20.36 chains to ⅛ Post: W. O. 14 N 67° E 177 links 20
Hickory 4 " 2 " 66
North 20 chains to 1/16 Post = W. O. 30 N 79¾ W 78½ 22
" " 5 " 3 E 29
West 40.70 chains to 1/16 Post = W. Walnut 8 N 27½ W 23 25
Sugar 11 S 89 E 46
South 20 chains to ⅛ Post = W. O. 14 S 66½ W 37 23
" " 11 N 15 E 28½
East 20.06 chains to the place of beginning
I ~~Certify~~ that the above is a correct record of Survey made by me; April 1st 1848 Geo. R. Stuntz
District Surveyor G. L. W. T.
By Stephen Mahood Deputy

No 540

Survey made for Valentine & John Petts of 21.5/100 Acres of land off the West side of the W½ of the S.W¼ of Section No. 11 & 10 Acres in the S.E¼ of the S.E¼ of Section 10-all in T3 N-R1 west of the 4th P.M.
S.E¼ of Sec 10 & S.W¼ of Sec 11-T3-R1 west

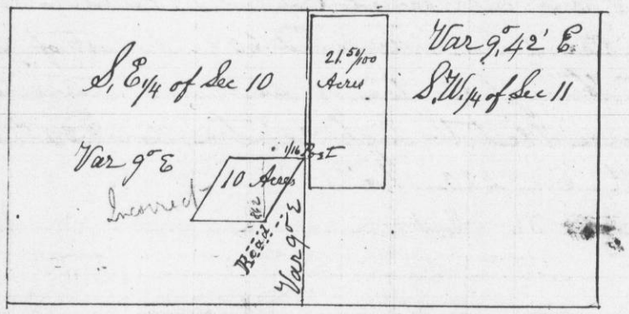

Commencing S 45° E 29 Links from ¼ Post between Sections 10 & 11-T3-R1 W-Thence South 21.50 links to Burr oak 3 inches Diam^ter-Corner-Thence East 10 chains-Set Post-W. 0.55 47¾ E 28 Links-B. 0.10 West 48½ links=Thence North 21.50 links Set Post-B. 0.85 39¾ W 21½ links=B. 0.85 32 E 24 Links=Thence West 10 chains to the place of beginning-Thence from ¼ Post South Set 1/16 Post on the line between the S.E¼ of Sec. 10 & the S.W¼ of Section 11-T3-R1 W-B. 0.5 West 36 Links-B. 0.3 N 58° E 2 Links-Bearing at ¼ Post-Thence S 30½° W. 10 chains: Set post. B. 0.4 west 23 Links=Thence West 10 chains Set post-B. 0.5 N 34° E 26 links=B. 0.4 53 6° E 21 Links-Thence N. 30½ E 10 chs Set post B. 0. 5 52 5/2 W 45 links=B. 0.3 N 36½ E 4 links=Thence East 10 chains to the place of beginning
I hereby certify that the above is a true plat & minutes of Survey made by me April the 6th 1848
Geo. R. Stuntz
District Surveyor
By Stephen Mahood
Deputy