Survey made for John Mc David

of the North East quarter of the South West quarter of Section No 23 in Township No. 2 North of Range No. 2 West of the 4th principal Mer. Corners all established by running the through the Section & through S.W. 1/4 North & South and East and West as the Law directs and as represented on the following diagram by the dotted lines

Sec. No 23. T. 2 N. R. 2 W.

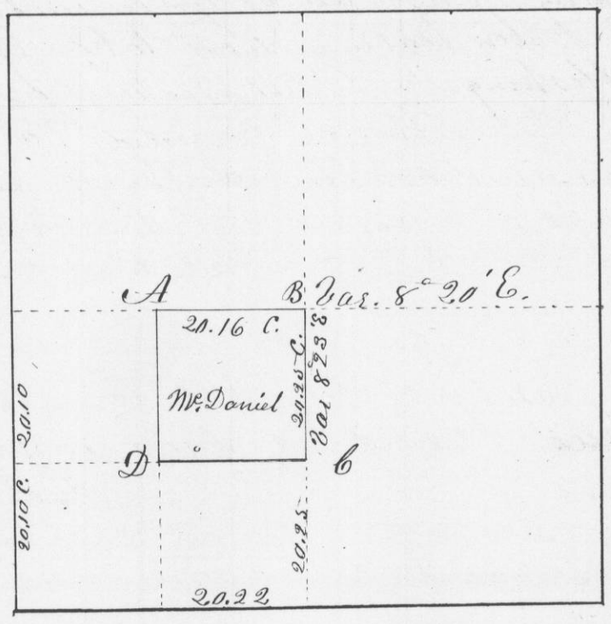

Corners at A. { White Oak 9 N 52 W 140
do 6 N 87 E 113

" B { W O 10 N 24 W 108
do 9 S 4 W 204

" C { W O 12 W 46 1/2 E 271
do 6 S 8 E 383

Corners at D { Bl. O 12 S 77 W 118
Bs 6 9 S 74 E 221

A true plat & record of Survey made March 19th 1849

Geo R Shuntz
Co. ... to Survey

Survey made for Henry L Mafsey in Section No. 1 in Township No. 2. North of Range No 3 West of the 4th principal Meridian Commencing at North West Corner of said Section. The Original bearing trees having been destroyed by cutting I established the corner by measuring the required Course & distance from their stumps and marked the following for new bearings { Bur Oak 24 S 30 W 61 links
White Oak 18 S 24 E 112 links Thence East variation 8.30' E. At 40.10 C. I intersected at quarter Section post: the bearings of which had also been destroyed: and marked the following tree for a new bearing { White Oak 28 S 64 E 17 links Thence Corrected back 20.05 Chains and established 1/8 post { W.O. 10 N 14 W 61 links
W.O. 18 S 31 W 100 links

Thence run South to the 1/8 post established by Jas. E. Freeman and recorded No. 220 Dist Surveys

I hereby certify that the above is a correct record of the field notes of said Survey made by me the 19th day of March A.D. 1849

Geo. R. Shuntz
District Surv.
of G. L. M.