№ 583

Survey made for August Blaufuss & John Benner of the N.E.1/4 & the S.E.1/4 of the N.W.1/4 & the S.W.1/4 of the N.E.1/4 of Section № 4 of T5 N. in R. № 2 West of the 4th Principal Meridian also the last mentioned qr. 1/4 divided between the said Blaufuss & Benner

N.1/2 of Sec-4-T5-R2-

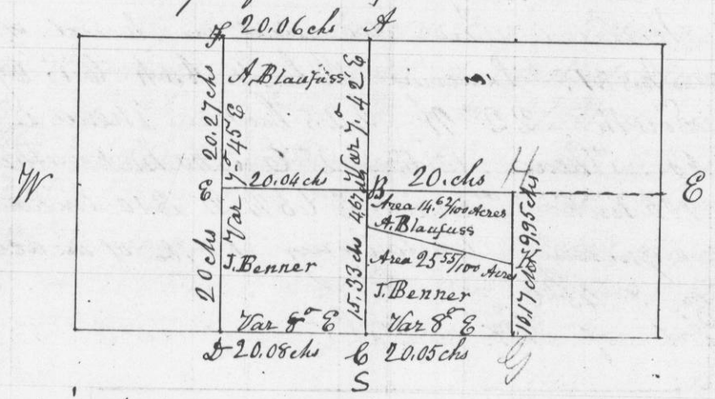

Commencing at the 1/4 post on the East side of Section, thence West thro the Centre of Section 80.28 chains to 1/4 post on west side of Section Var 8° intersected at 1/4 post; thence from N.W. corner of Section East on Town line to N.E. corner; Established 1/4 post (on Town line 22 links west of original 1/4 post) A; thence South thro; Centre of section, to 1/4 post on south side, Var 8°.15' E intersected 78 links west of 1/4 post; corrected back & set centre, 1/4 post at C, post marked 1/4 S, set in mound; corrected & set 1/8 post at D, Double Br, 0.24 S 75° E 203 links = Thence North 40.27 chs to 1/8 post at F; set post in mound; Corrected back to 1/16 post at E Br, 0.8 N 14 1/2 W 46 links = Br, 0.7 S 67° E 24 links - Thence East 20.04 chains to 1/16 post at B; Br, 0.7 N 19° W 81 links - Thence East to section line to temporary post = Thence from 1/8 post at G. (Br, 0.55 33° E 28 links W. 0.9 S 53° W 58 1/2 link) North to 1/16 post at H. Corrected & set post W, 0.24 N 15° E 113 links, Thence South 995 links to post K between Blaufuss & Benner, Br, 0.14 N 49° E 115 links; Thence N 75°.45' W 20.71 links to post at I; W, 0.18 S 46 W 206 links; post is 4.67 links South from 1/16 post at B. - - - I hereby certify that the above and foregoing is a to plot & correct minutes of Survey made by me this 27th day of April A.D. 1849

Geo. R. Stuntz
District Surveyor
G.C. Wis

pr Stephen Mahood

No. 584

Survey made for Edward Jeffrey Lardet. D. Mitchell and William Richards in the N.W. quarter of the South East quarter of Section No 26 in Township No 3 North of Range No. 3 West as shown by the following diagram. Distances on plot given in links

N.W. 1/4 of S.E. 1/4 of Sec 26 T. 3 R 3

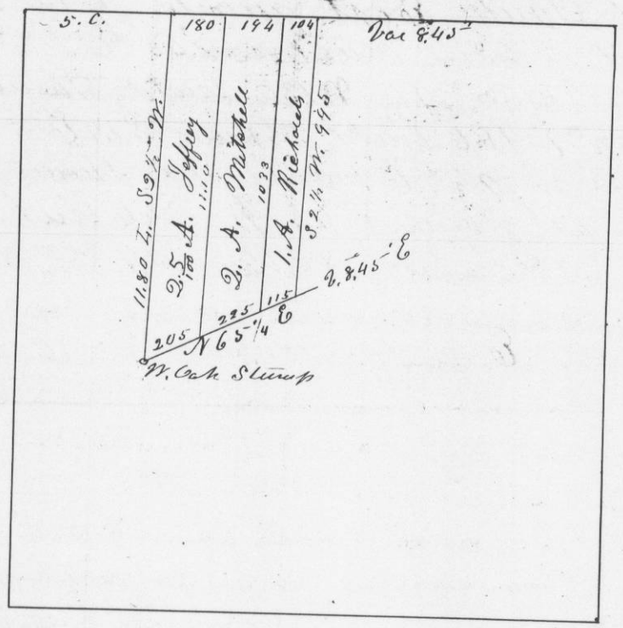

Scale 5 chains to the inch

Jeffreys N.W. corner is 5 chains East of the W. Corner of the Said N.W. 1/4 of S.E. 1/4 and his S.W. cor at a W.O. Stump I hereby certify that the above is a true plot of said survey made by me May 4th 1849.

Geo R Stuntz District Surveyor of G.C. Wis