No. 25 Q. 1

Survey made for Thomas Utt, Elias Utt Ira. C. West and Naut in James in Sections No. ten (10) and eleven (11) in Township No. three (3) North of Range No. 2 West of the 4th principal meridian.

Commencing at the 1/4 Section post between said Sections. Thence West in Sec. 10. Var. 8° 40' E. 40. chains set Temporary 1/4 post. On West side of Section Intersected 80 links North of 1/4 Sec. post. Thence run South from 1/4 post on North side of Sec. 10. Var. 9° E. at 39.80 chains Intersected 24 links West of Temporary 1/4 post; on South side of Section intersected 16 links East of 1/4 Sec. corner. Thence run East Variation 9° E at 40.14 chains Intersected 5 links South of Section corner. Thence corrected back 20.07 chains and set 1/8 Sec. post. Thence run North from 1/4 Sec post on East side of Sec. 10. Var. 9° E at 40. chains Intersected 45 links East of Sec. corner. Thence corrected back 20. chains and established 1/16 Sec. corner. Thence run West Var. 9° 5' E and established 1/16 Sec. corner North of the center of Sec. on the corrected line. Thence run South 20.10 chains and set 1/4 Sec. post in center of Section. Thence East from the NW corner of Sec. 11. Variation 9° E. at 39.74 chains Intersected 24 links North of 1/4 Sec. post. Corrected back and established the 1/8 post at 19.87 chains. Thence run South from 1/4 post on North side of Sec 11. Var. 9° 40' E at 40.0 Set. Temporary 1/4 post Intersected on South side of Section 22 links East of 1/4. post. Thence run West from 1/4 post on the East side of Sec. 11. Variation 8° 40' E at 39.77 chains intersected 12 links South of Temp post at 79.64 Intersected 23 links South of 1/4 Sec. post bet. Sections 10 & 11. Thence corrected back 19.90 links and established 1/8 post. Thence corrected and established

continued

quarter Section post in the center of Section. Thence run North and established 1/16 post North of center. Then run East from 1/4 post on the North side of Section 11. Variation 8° 40' at 39.80 chains Intersected the links North of Sec. corner. Corrected back 19.90 chains and established 1/8 Sec. post. Thence run South through the N.E. quarter of Section. Thence run West through the center. Corrected and established the 1/16 post in the center of the N. E. quarter.

Thence Commencing at the South West corner of Section 11. run East to the center of the West 1/2 of the S. W. 1/4 - 9.95 chains and set post - Bearing {W Oak 14 S 1° W 60 links. Thence North 31.00 chains and set post - Bearing} Black Walnut 9 South 24 links. Thence run West 9.95 chains to Section line and set post - Bearing} White Oak 20 N. 5. W. 37 links. Thence North on said line 9 chains to the quarter Section corner.

Section 10. T. 3. N. 2. W. Section 11 T. 3. N. 2. W.

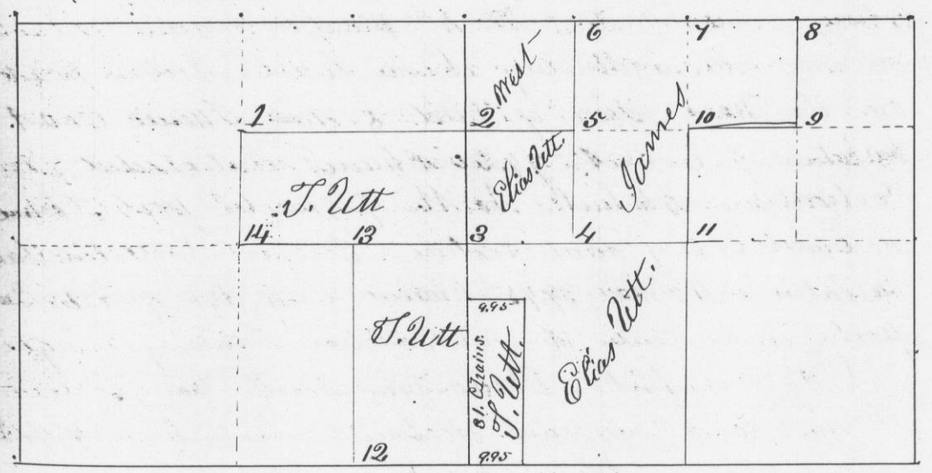

Bearings established at the corners

at 1 { White Elm 12 N 74½ W 58 links; Sugar 9 S 10 E 79 links

at 2 { Black Oak 14 S 65° E 18 links; Black Oak 9 N 51½ W 26 links

at 3 { Original

at 4 { White Oak 30 N 85 E 147 links; White Oak 16 N 11 E 156 links

at 5 { Elm 14 N 58° W 26 links; Bur Oak 14 N 19 E 94 links

at 6 { White Oak 24 S 80 W 17 links; White Oak 14 S 26 E 85 links

See next page