№ 609

Survey made for Augustus C. Murray of the Sections № 20 & 21 - T4 - R5 west of the 4th Principal Meridian Nov 14 & 15th 1849

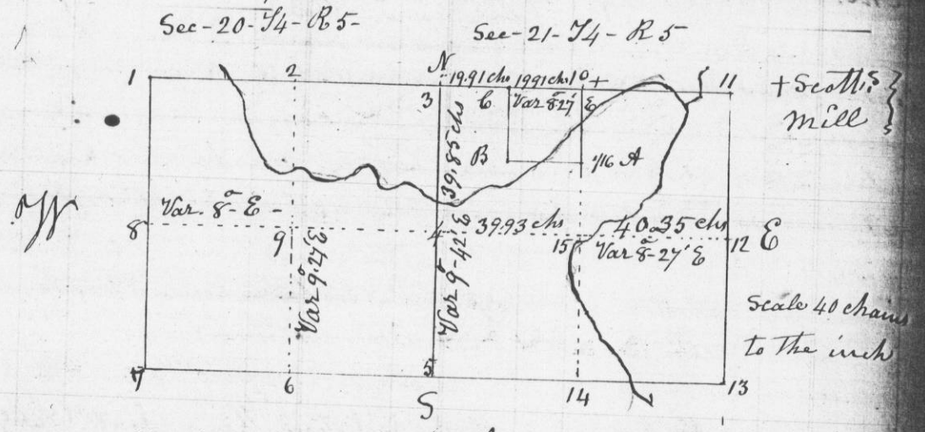

Corners & Bearings

at 1 Post in Mound
" 2 " "
" 3 " "
" 4 W. O. 8 N 6½ E 490 links
" " 17 N 36 W 506 "
" 5 Post in Mound
" 6 Br. O. 8 S 5° E 457 links
W. O. 10 S 4 W 592 "
" 7 Post in Mound
" 8 " "
" 9 W. O. 20 N 66° W 217 links
Br. O. 20 N 7 E 246 "
at B Post Marked 1/16 S set in Prairie Bottom
" C Post Marked 1/8 S set in Prairie

at 10 W. O. 8 S 83° E 5.89 links
Br. O. 16 N 70½ E 6.23 "
" 11 Br. O. 6 N 41 W 1.97 or 2.97
W. O. 16 S 44¾ E 2.92 or 3.92
" 12 W. O. 18 N 49 W 53 "
" 24 N 6¾ E 2.44 "
" 13 Post in Mound
" 14 W or Br. O. 16 N 89½ E 782
" " O. 15 N 81½ E 751
" 15 Br. O. 11 S 66° W 240 "
3d — Hole in Rock West end North
" A Post set in Prairie Marked 1/16 S

I hereby Certify that the above is a true plot & Correct Record of Survey

Geo R. Stuntz
District Surveyor
G. C. W.
Pr Stephen Mahood
Deputy

№ 610

Survey made for Jacob Shullenberger of the E½ of the S.E.¼ the E½ of the N.W.¼ of the N.E.¼ of Sec - № 32 - T4 - R5 west of the 4th Principal Meridian Nov 17th 1849

Commencing at the 1/4 post on north side of Sec - thence South 80.34 links Var 10° E intersected 56 links East of 1/4 post thence East 40.67 links to Section corner Var 9° E intersected 114 links South of corner - thence north 39.88 links to 1/4 post - thence West to 1/4 post on West side of Section Corrected & Set 1/4 post in Centre & 1/8 post East of centre; no bearing from 1/8 post North to 1/8 post on Section line 39.87 links; corrected & Set 1/16 post. ~~Corrected & Set~~ Blk. O 9 N 54° E 23 links
Corrected & set W. O. 6 N 35 W 19 "
1/16 post North of Centre W. O. 18 N 35° W 275 links
Br. O. 15 S 82 E 217 "
E½ of Sec - 32 - T4 - R5 - 40.20 chs

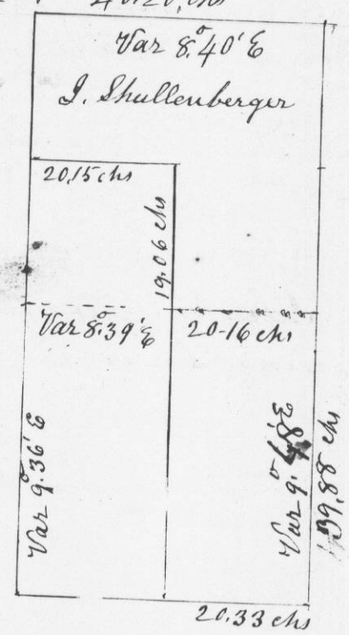

I hereby Certify that the above is a true plot & record of Survey

Geo. R. Stuntz
District Surveyor
G. C. W.
Pr Stephen Mahood
Deputy