No 617

Survey made for Daniel May and Wm. E. Geigsby in Section No 29 Township 3 North of Range No 3 West of the 4th principal Meridian
Jan. 4th 1850

Section 29. Township 3. Range 3

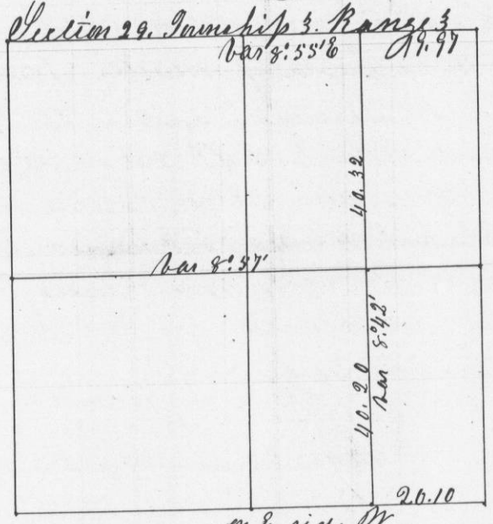

Beginning at 1/4 Post on E side W Bar 9° E 80.08 chains intersect 9 links South of 1/4 Post

E from 1/4 post on South Side 40.20 intersected 8 links N corrected 20.10 & Established 1/8 Post { W.O.18 N70 E 55 links / W.O.18 N69 W66 links

Thence N True Bar 8:42' E 40.20 ch Set 1/8 P { W.O.12 N85° E 20. / B.O.15 S76 W37.

Thence N 40.32 chains. Then W from N. E corner of Section Bar 9° E 39.94 intersected 11 links South of post. Corrected back 19.97 set 1/8 Post { W.O.10 S26 W33 / W.O.14 N37 W99

A true plat & record of Survey.

Geo R Stuntz
County Surveyor

No. 618

Survey made for Nickolas Fecht of the North East quarter of the South West quarter of the South West quarter of Section No 36 in Township No 3 North of Range No. 3 West of the 4th principal Meridian
Jan 29th 1850

Beginning at the N.E. corner of said S.W. 1/4 of S.W. 1/4 as established by J. E. Freeman { W.O.14 N27 W5 6 links / White Oak 14 N13 E42 links

Thence West Bar. 8.20' East 20.14 chains. Intersected Section line at 1/16 post corrected East 10.07 chains and Set Fechts N.W. corner. Bearing { Elm 14 S 87° W45 links

Thence run South from the place of beginning Bar. 8.30 E. at 20. chains Intersected Section line at 1/8 post corrected back 10. chains & Set Fechts S.E. corner

Thence run West 10.07 chains { W.O.13 N22 E 29 links

and Set S.W. corner Bearings { White Oak 14 S79 E 33 links / White Oak 18 West 8 links

Thence North 10. chains to the N.W. corner S.W. 1/4 of S.W. 1/4 of Sec 36 T3 R3

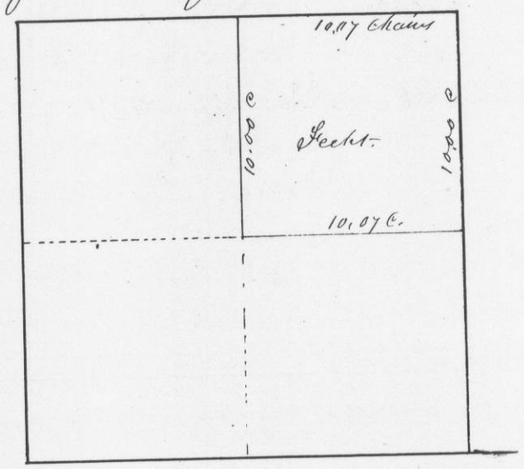

A true Record
Attest — Geo R Stuntz
County Surveyor