No 634

Survey made for Joseph Walker of the NE 1/4 & N 1/2 of SE 1/4 of Section No 31-T7-R2 west of the 4th Principal Meridian in Grant County in the State of Wisconsin--

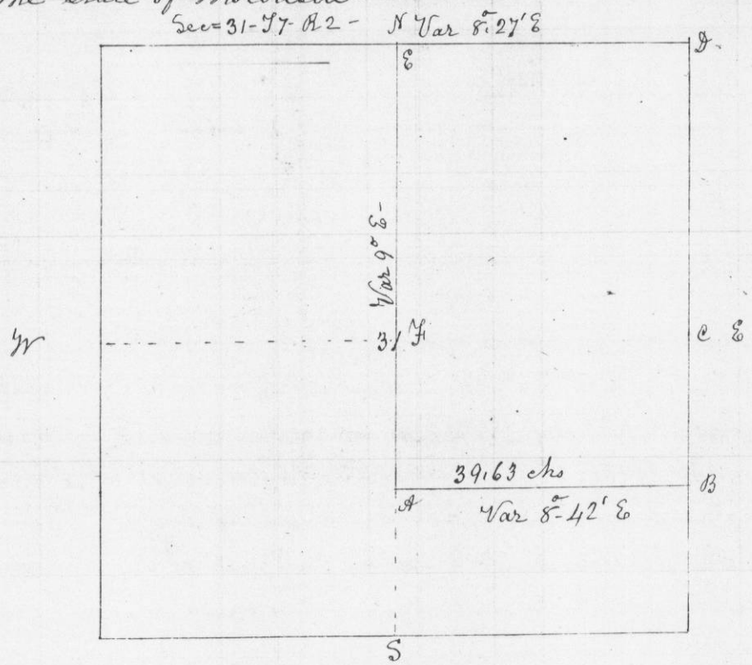

Established 1/16 Post at A. South of Centre-to wit

at A.	B. O. 16	S 60° E	82	links =	B. O. 12	S 82½	W	80	links	
1/16 P. at	B	W. O. 10	South	25 "	= W. O. 12	N 56	"	60	"	
1/4 " "	C	B. O. 11	S 1° W	6.54 "	= B. O. 14	" 47	E	5.27	"	Original
Cor - "	D.	Hickory	S 9° N 72½	E 5.54	= W. O. 4	S 4	W	13	"	"
1/4 P. "	E	W. O. 10	N 21° W	3.20 "	= Br. O. 10	" 12	E	3.19	"	"

1/4 " F Established 1/4 Post in centre of Sec- By running from 1/4 Post to 1/4 Post, East & West & North & South thro. section - Set Post F in Prairie * (alias B. O)

I hereby certify that the above is a is a true Record of said Survey made Oct 29 AD 1850

Geo. R. Stuntz
District Surveyor
G. C. Wis

R. Stephen Mahood
Deputy

No 635

Survey made for Arnold Moody & others in Section No 1-T6-R3 west of the 4th Principal Meridian.

Sec-1-T6-R3--

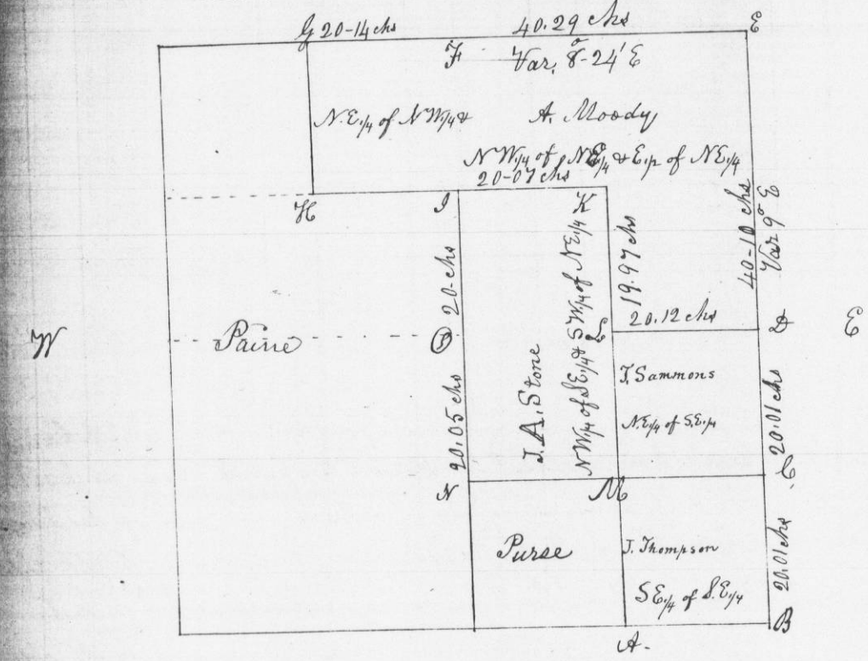

Established

1/8 Post at	A B. Oak	5	S ½°	E	106	links =	No Other			
1/16 " "	C W. O	28	N 7⅔	W	20	" =	" "			
1/4 " "	F Br O	10	S 35	"	532	" =	W. O. 16 S 22½°	E	4.67	links
1/8 " "	G Br O	8	" 49	E	105	" =	W. O. 16 " 44	W	131	"
1/16 " "	H W. O.	22	" 62⅓	W	115	" =	No Other			
1/16 " "	I B. O.	18	N 53	"	5½	" =	W. O. 13 S 17⅓°	E	14	"
1/16 " "	K W. O.	14	S 11	"	26	" =	" " 16 N 20	W	13	"
1/8 " "	L " "	16	" 78	E	22	" =	" " 14 " 40½	"	72	"
1/16 " "	M B. O	14	N 83⅓	"	168	" =	" " 24 S 16	E	153	"
1/16 " "	N Br. O.	9	" 28¼	W	14	" =	" " 13 N 78½	"	75½	"
1/4 " "	O W. O.	14	" 6	E	27	" =	B. O. 12 S 87¾	W	38	"

B. D & E Original = The above Sub-division of Sec- No 1- T6 R3 = was made by running from N.E. Corner to N.W. corner of said Sec- & Establishing 1/4 Post on Town line; and running thence South thro. Sec- to 1/4 Post on S. side; and from 1/4 Post on West side of Sec- to 1/4 Post on East side of Section as the Law requires = and other sub-divisions made in the same manner

I hereby certify that the above is a true Record of said Survey made November 1st & 2d AD 1850

George R. Stuntz
District Surveyor G. C. Wis

R. Stephen Mahood
Deputy