No 642.

Survey made for William and Joseph Brandon in Section twenty one, in Township two North, of Range one West 4th Principal Meridian June 13th 1850

Beginning at the quarter section Corner on the East Side of Said Section, Thence North Var 8°30' E — At 39.82 chains intersected Section Corner

Thence W Var 8°30. at 39.90 intersected 52 links N of 1/4 P.

Thence S Var 8°.30' E at 79.81 intersected at 1/4 Section P

Thence E Var 8°.30 at 40.04 chains intersected 18 links S of P.

Thence N Var 8°.30' E at 40.30 chains intersected at 1/4 P.

Thence W intersected 30 links N of intersected section line 24 links N of 1/4 P on W side of Section. Then corrected back & Established the center { B.O. 12 N 39 1/2 E 65 links / Br.O. 8 & S 35° E 122 links

Thence N 19.91 ch & set 1/16 P. { Br O 9 N 14 1/2 W. 69 links

Thence E Var 9°.5' E intersected 6 links S. corrected & established 1/16 Past — Bearings { W. O. 12. S 53 E 69 links / Br O 12 N 10 1/2 E 166 links

Then S through center of N.E. 1/4 corrected back and established 1/16 Past center { Br O 8 & N 54 & 158

Then set 1/8 P E of center in Mound.

Thence S 20.08 & set 1/16 P. Thence S 20.08 ch & set 1/8 P in Mound.

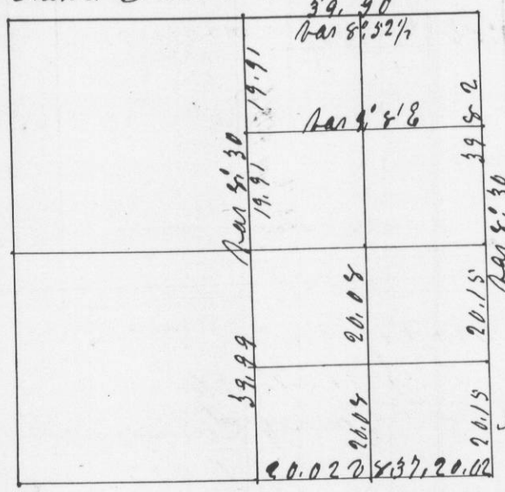

A true plat & record.
Geo R Stuntz
County Surveyor
G.C. Ms.

Survey made June 14th 1850 for James Smelser of the W 1/2 of the S.W 1/4 of Section 17. T. 2. R 1.

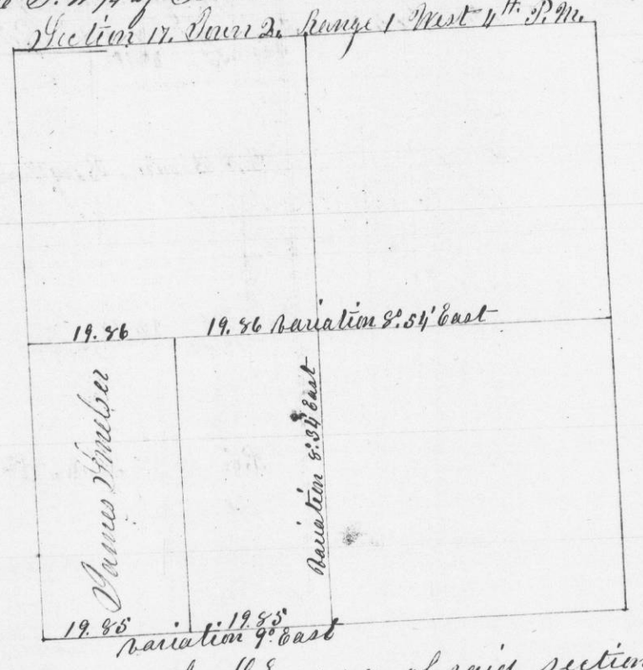

Beginning at the S.E corner of said section thence West. Var 9° East. At 79.40 chains intersected section line near corner of said section. Corrected Back 19.85 chains and set 1/8 Past. Bearings { B.O. 8 N 16 1/2 E 47 links / B O 8 N 31 W 51 links

Then East 39.70 chains set 1/4 Past in place of original which has been destroyed New Bearings { Aspen 6 N 85 E 23 links / Aspen 4 S 37 W 8 links

East through the center. Variation 9° East. intersected 12 links North of 1/4 Past.

Thence North through the center of said section Var 8°.30 East Intersected 8 links East of 1/4 Post on North side of section. True Variation 8°.84 East; Corrected back & set center 1/4 Post

Bearings { Br O. 4 S. 57 E. 109 links / Ash 7 N 64 E 194 links

Thence West 19.86 chains & set 1/8 Past { Br O 6. S. 61. W 2.26 / Br O 5 S 19 W 2.58

Thence South to 1/8 Past. A true record & plat. Geo R Stuntz
County Surveyor