Survey made for Patrick Coin of the W½ of the S.W¼ & the S.E¼ of the S.W¼. for Rees Jenkins of N.E¼ of S.W¼ & S.W¼ of S.E¼ & for Robert Ramsey of the W½ of N.W¼ of Section 33 Town 4. Range 5 Made April 18th 1851.

Section 33 Town 4 Range 5.

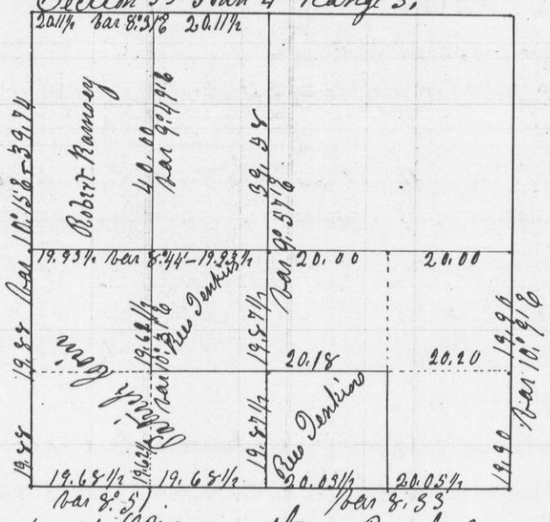

Beginning at S.W Corner. thence North Bar 10°E at 39.76 chains intersect 17 links East of ¼ Post at 79.50 chains intersect 35 links East of Section Corner. Correct Back 19.74 chains. Stone in mound

Thence East through center of section Bar 10.15' at 20.40 & 60 chains set temporary posts at 79.87 intersect 2.13 chains N of ¼ Post

Then South through the center of said Sec. Bar 9°.30E – at 38.52 ch intersect 44 links W of Temporary center Post. At 79.33 ch intersect 63 links W. of ¼ Post. correct Back 19.87½ ch & Established 1/16 Post South of Center. Bearings { Hickory 8 S.33½ E 2.29, Do 5 N 74 E 2.32. and at 39.75 ch established Center Bearings { Hickory 7. S 82 W 96, BO 5 N 42 E 2.43

Then W from ¼ P on S Side Bar 9°.5'E at 39.37 ch intersect S of Sec Post 77 links. Correct Back 19.68½ & established 1/8 Post

Bearings { Br O 10 N. 11°E 171, Br O 6 S 89 W 111.

Thence N Bar 9°.37' at 20.00 ch set temporary 1/16 P at 39.24 ch intersect 63 links East of Corrected 1/8 Post, 1/8 Post N of Center { Br O 14 N 87°E. 3.69, Do 12 S 59 E 2.80

Thence N Bar 10.38 at 40.00 ch set Temporary 1/8 Post.

Then from N.W Corner of Said Section East Bar 8°35'E at 19.64 intersect 15 North of Temporary 1/8 P & at 40.23 ch intersect 28 links north of ¼ Post Correct Back 20.11½ and set 1/8 Post E of N.W Corner

Bearings { B O 8 S 3/4 E 121, Do 7 S 33½ E 1.63

1/16 Post N of S.W Corner Corrected Bearings { Hickory 8 N 33 W 1.75, Br O 7 N. 33 W 1.56

Thence E Bar 9° E intersect 22 links South of Temporary Center of S.W¼ 431 links North of 1/16 Post South of Center Corrected & established Center of S.W¼ in mound { 1/16 P S of Center Bearings { Hickory 8 S 33½ E 2.29, Do 5 N 74 E 2.32. refutation

Then from ¼ Post on S Side of Section Bar 8°.51'E, East at 20.00 ch set temporary 1/8 Post, at 40.11 intersect 14 links North of Post at S.E Corner of Section.

Thence N. Bar 9°.5'E at 20.00 ch set temporary 1/16 Post at 39.80 ch intersect 14 links E of ¼ Post. Correct Back 19.90 chains

thence W across center of S.E¼ at 20.00 ch set Temporary 1/16 Post. at 40.38 chains intersect 16 links South of 1/16 Post South of Center of Section Bar 8°.51'E.

Then from 1/8 Post E of Center Bar 9°.5'E South through center of S.E¼ intersected 18 links West of Temporary 1/16 Post near center of S.E¼ & 5½ links East 1/8 Post Corrected W of S.E corner

Bearings { Br Oak 10. S. 82 E 2.35, Do 8 N 69½ W 3.29

Correct Back and established 1/16 Post Center of S.E¼

Bearings { Br. O 10 S. 64½ W 1.62, Do 7 N 81 W. 1.10 } – Backs. Patrick Coin. & Rees Jenkins Marker & Chainmen were duly sworn.

A true plat and record of survey.

Attest

John T. Everett
County Surveyor

B. T. G. Clark
Deputy County Surveyor