No 662

Survey made for George Bastedo of the E½ of the N.W¼ & the E½ of of the N.W¼ of the N.W¼ of Section 35 Town 5 Range 5 May 6th 1851

Section 35 Town 5 Range 5

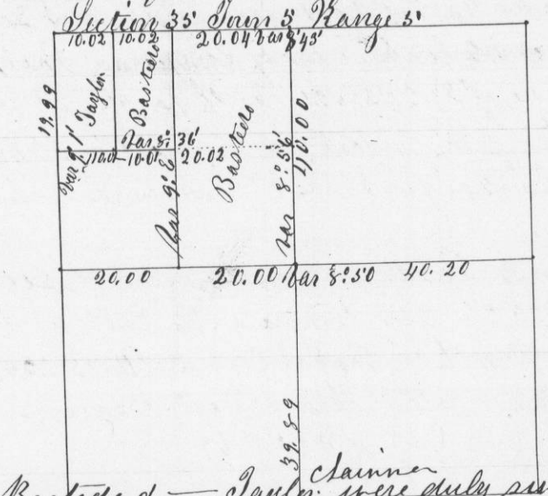

George Bastedo & — Taylor Stinner were duly sworn.

¼ Pat Center. Bearings { Bx Oak 10 N 79 E 8.34
Do S 85 E 518

1/16 Post N of Center. In mound
1/16 P S of N.W Corner In mound
1/8 P. W of Center In mound
1/32 Post 10.02 chains E of N.W. Corner In mound.
1/32 Post 10.01 chains E of 1/16 S of N.W. Corner In mound

1/16 P. Center of N.W¼ In mound.
1/8 P. E of N.W. Corner In mound.

I hereby certify that this survey was made according to law & that the above plat & field notes represent the corrected variation of the several lines. their several lengths & also the corners as established

John D. Everett
County Surveyor
By D. G. Clark
Deputy County Sur

No 663

Survey made for N. Taylor of the N.E. ¼ of the N.E ¼ of Sec 34. Town 5. Range 5. and the W½ of the N.W ¼ of the N.W ¼ of Sec 35. Town 5 Range 5. May 6th 1851.

Section 34. Town 5. Range 5. N.W ¼ of Section 35. T. 5. R. 5.

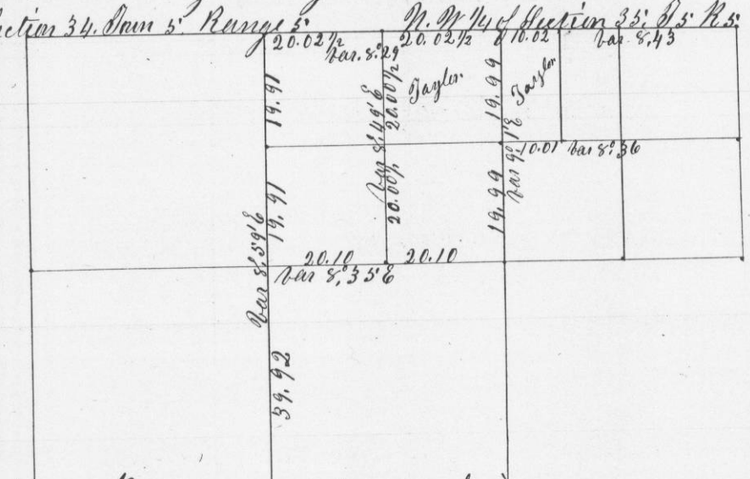

George Bastedo & — Taylor Stinner — were duly sworn

1/8 P. W of N.E Corner In mound
1/16 Center P. of N.E ¼ In mound
1/16 P South of N.E Corner In mound
N.E Corner, original Bearings

In Section 35. Town 5 Range 5

1/32 P 10.02 East of N.W Corner In mound
1/32 P 10.01 East of 1/16 P South of N.W Corner In mound.

I hereby certify that this survey was made according to law & that the above plat and field notes represent the corrected variations & lengths of the several lines and also the manner of Establishing the several corners.

John D. Everett County Surveyor.
By D. G. Clark. Deputy County Surveyor.