No 683

Surveyed October 16th & 17th 1851 for Michael Weaver the East half of the North West quarter and the North East quarter of the South West quarter of section thirty one in Township six North range four West of the fourth principal Meridian in the county of Grant and state of Wisconsin viz

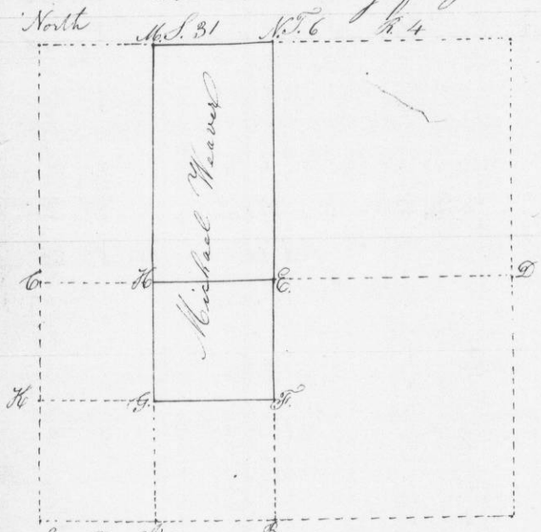

Corner at "N." Original 1/4 Sec

" " "E" intersection of B-N & C-D

Bearings White Oak 13 S 40½ E 53
Do Do 8 N 82½ W 28

24 " "I" Equidistant from B. to E.

Bearings White Oak 14 S 62½ W 139
Bur Do 8 S 86½ E 149

"G" Intersection of I-H & K-F

Bearings White Oak 20 S 85½ W 195
no other near

"H" ~~Equidistant~~

12 Bearings Bur Oak 7 S 12½ E 67
Black " 8 S 87½ W 105½

M Post in Prairie

A true record of Survey
John T. Everett
County Surveyor
Grant Co. Wis.
By C.T. Everton Deputy

No. 684

Surveyed Oct. 25th 1851 for Messrs Taft & Schuyler the West half of the South West quarter of section twenty four, the North West quarter of the North West quarter of section twenty five, the East half ~~of~~ & and the North West quarter of the North East quarter of section twenty six in Township five North range five West of the fourth principal Meridian in the county of Grant State of Wisconsin viz

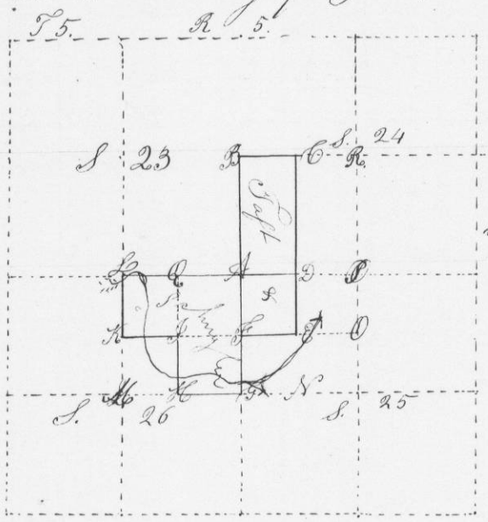

Variation 5¼° East

At "A." original Section corner

"B." " 1/4 Sec cor.

"C." equidistant from B to R 1/8

Bearings White Oak 20 N. 26¾ E. 48½
Do Do 18 N. 63½ W. 167

12-24

"D." equidistant from P to A 1/8

Bearings White Oak 3 S 68½ W. 56
Do Do 19 N. 49¼ E 124

"E" Intersection of N-D & P-O 1/16
no tree near

"F" Equidistant from G to A 1/16

"G" Original 1/4 Section corner

"H" equidistant M-G. 1/8
no tree near

"I" Intersection H-Q & K-F 1/16
no tree near

"K." equidistant M-L 1/16
no tree near

"L" Original 1/4 Section corner

A true Record of Survey
John T. Everett County Surveyor
Grant Co Wis
By C.T. Everton Deputy