No. 726 Aug. 3 1853

Surveyed for William Hampstead the East half of the North East quarter & the East half of the South West quarter of section twenty five in township two North range one West in Grant Co. Wis. as set forth by the following plat & notes viz

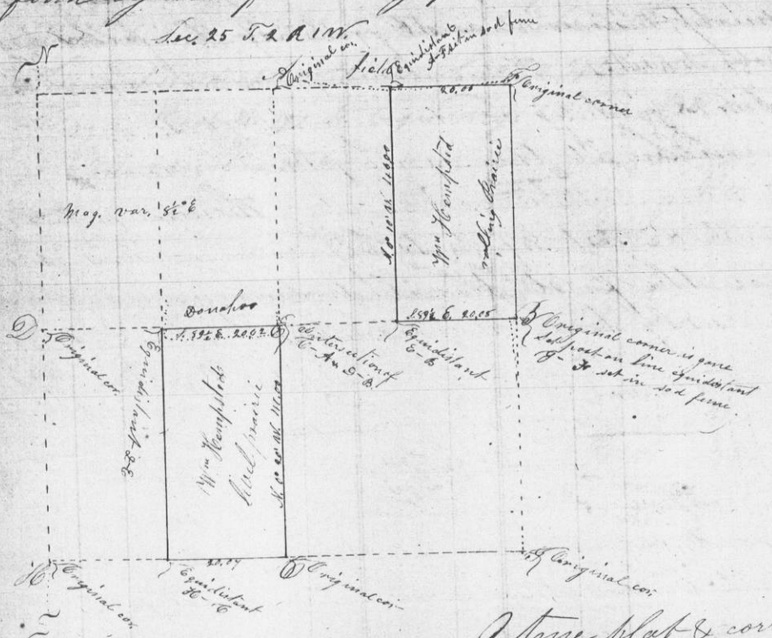

A true plat & correct copy of Notes of Survey John T Everett Co Surveyor Grant Co Wis
By C. T. Overton Deputy

No. 727 Aug. 10th 1853

Surveyed for Edward Stobel part of the North West quarter of Section 15 Township 3 North range 1 west in Grant County Wisconsin, to wit. Commence at a stake from which the North East corner of the Stone Academy bears South 4° East 5,23 links distant – Thence North 73½° West 5,00 chains thence North 16½° E. 5,00 chains – Thence South 73½° E. 5,00 chains – Thence S. 16½° West 5,00 to beginning containing 2½ acres.

Also commence at the same place – Thence N. 73½° East 44 feet Thence North 16½° East 85 feet – Thence S 73½° E. 44 feet Thence South 16½° West 85 feet to beginning. – This is contained in the first described survey

Courses by true Meridian Mag. variation 8½° East

C. T. Overton Dept Co Surv
J. T. Co Wis

No. 728. Grant Co. Wis — Sep 1st 1853

Surveyed for Nicholas Jenkins a piece of land lying in the South East quarter of Section ten – township three North range one West in said county of Grant to wit:

Commence At North West corner of lot belonging to Jonathan Moore – Thence N 16½° E. 6,32½ chs – thence S. 73½° E. 6,32½ chs – thence S 16½° W. 6,32½ chs thence N. 73½° W. 6,32½ chs to beginning containing – small fraction over four acres.

Everett Co Sur
By Overton Deputy