No. 734.

Oct. 27th 1853.

Surveyed for John Lee the West half and the South East quarter of S. W. quarter of section four in town One North Range one West in Grant county Wisconsin as shown in the following Plat:

Sec 4 T. 1 N. R. 1 W.

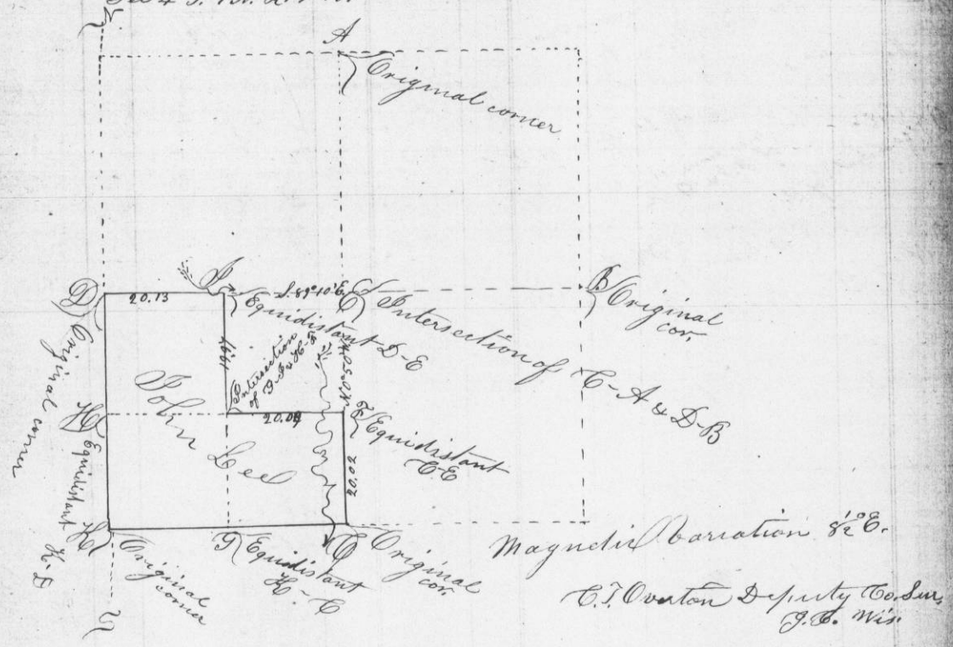

C. J. Overton Deputy Co. Sur.
G. C. Wis.

No. 735

Nov. 2nd 1853

Surveyed for G. King & Joseph Richards the East half & West half of the South West ¼ of Section four in township one North range two West in Grant County Wisconsin as shown in the following plat to wit:

Sec 4 T. 1 N. R. 2 W.

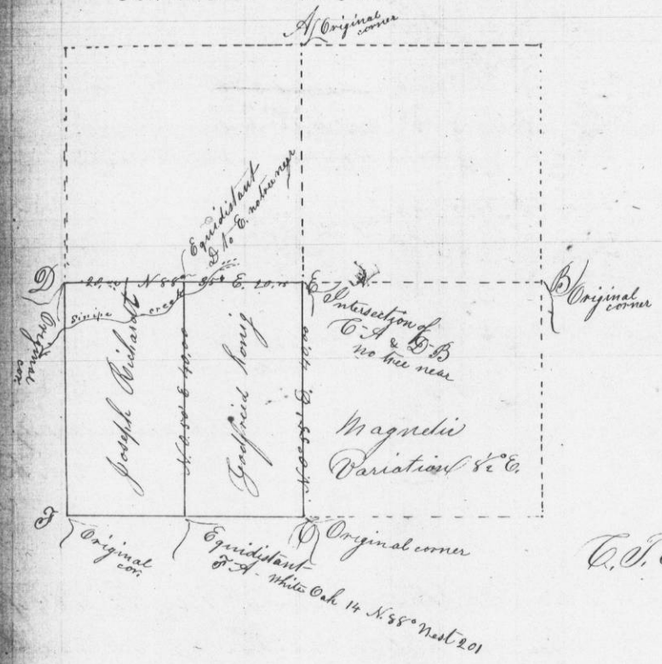

C. J. Overton Deputy Co. Surveyor