No. 775

Jan. 9th 1855

Survey for Lewis Beckett the S.W. 1/4 of the S.W. 1/4 of Section 27 in township 3 N. R 2 W. as shown in the following plat & Notes to wit:

Sec. 27 T 3 N. R. 1 W.

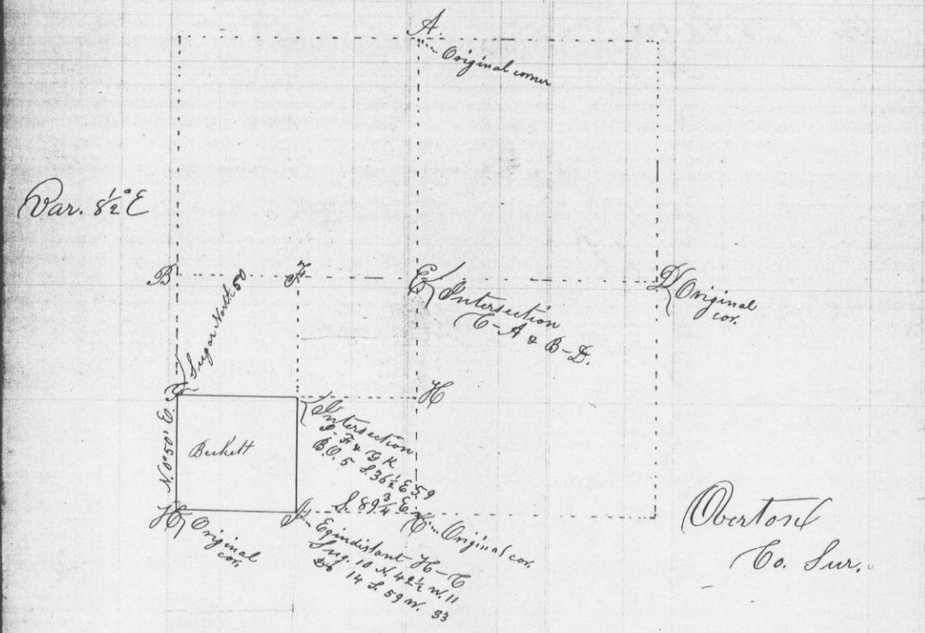

No 776

Jan. 1855

Survey for James Dyel the S. 1/2 of the N. E. 1/4 and the N. E. 1/4 of the S. E. 1/4 of Sec 27. in township 4 N. R. 1 W. — Plat & Notes
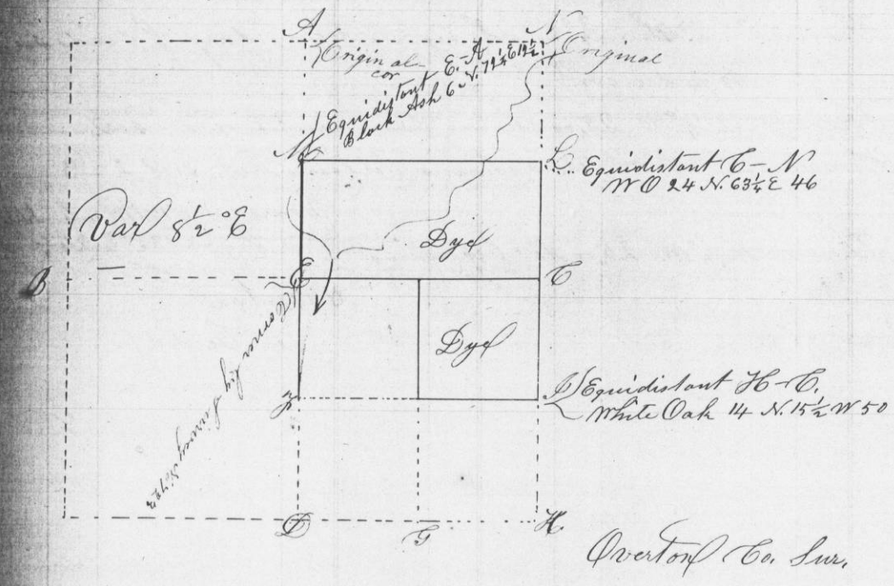
Sec 27 T. 4 N. R. 1 W.