Jan 22nd 1855

Survey for Jonathan Neil & Cook — parts of Section thirteen in Township two North Range two West as shown in the following plat.

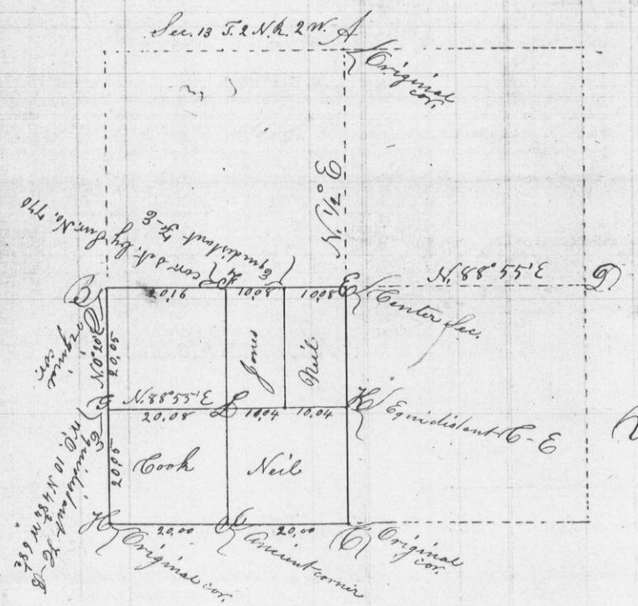

Var 8½° E

Overton Co. Surv.

No. 780

Jan. 23rd 1855

Survey for Wm Rodd & Tobias Luke part of sec. 12 T. 2 N. R. 2 W. as shown in the following plat.

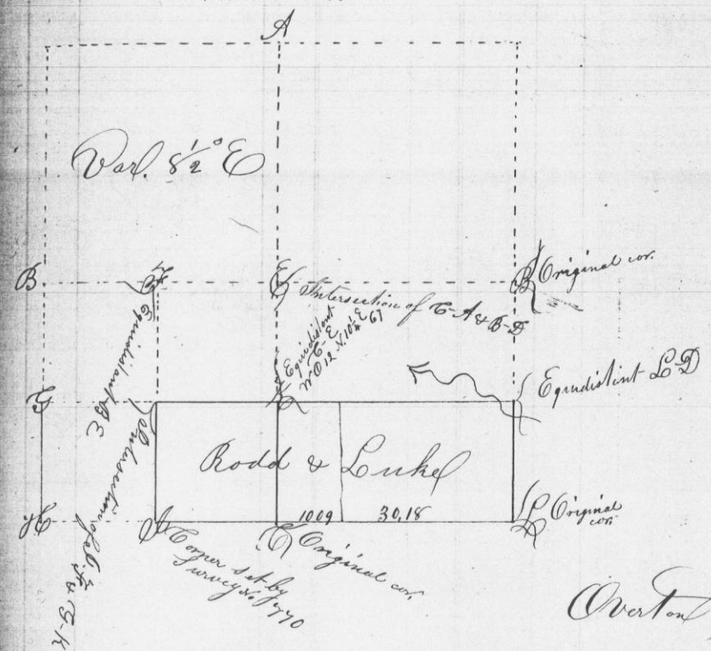

Overton