No. 803

May 10th 1855

Survey for John Williams parts of section one in township 4 North range one West shown in the following plat viz.

Sec. 15 T. 4 N. R. 1 W.

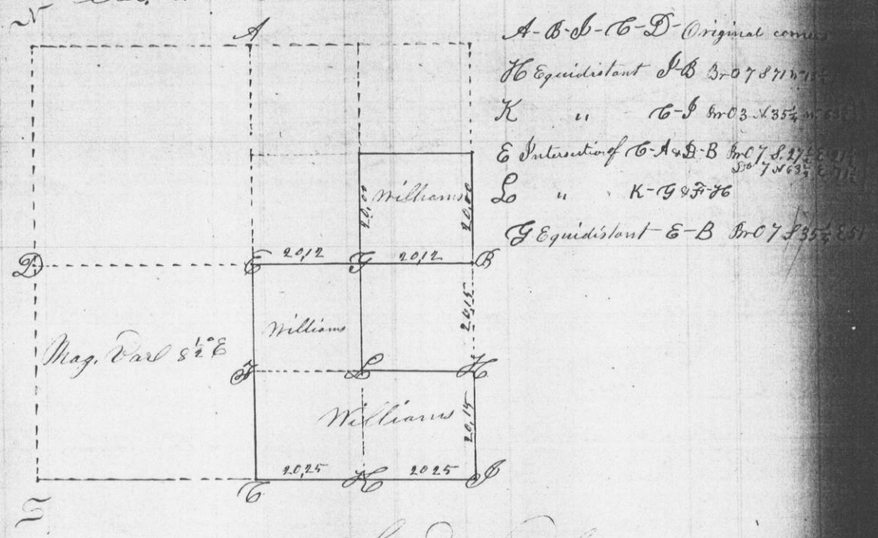

Surv'd & rec'd by
C. T. Overton
Co. Surv.

No. 804.

May 22nd 1855

Survey for John Newman to wit: Commence at the 1/4 section corner between sections 1 & 2 in township 4 N. Range one West at which placed a blue limestone 10 inches long & 6 inches square — Thence S 0° 38' E 20.20 chs & set limestone 10 inches long 7 inches wide & 4 inches thick Thence S 0° 38' E 20.20 chs to section corner at which placed a limestone 15 inches long 12 inches wide & 2 inches thick (& also set post) 18 links west of corner in stream

Overton Co. Surveyor