No 519

July 21st 1855

Survey for Alonzo Sweet the North half of the South East quarter of Section nine in township three North range three West in said County of Grant State of Wisconsin — shown in the following plat viz:

Sec. 9 T. 3 N. R. 3 W.

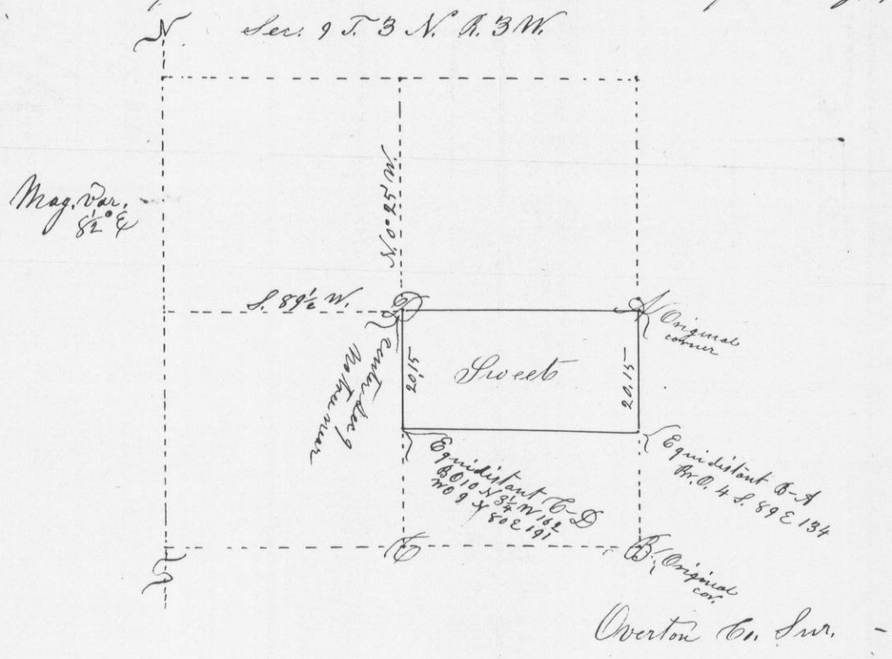

No. 520

July 27th 1855

Survey for Mathew Preston part of Section 15 in township 6 N. R. 1 W. shown in the following plat viz:
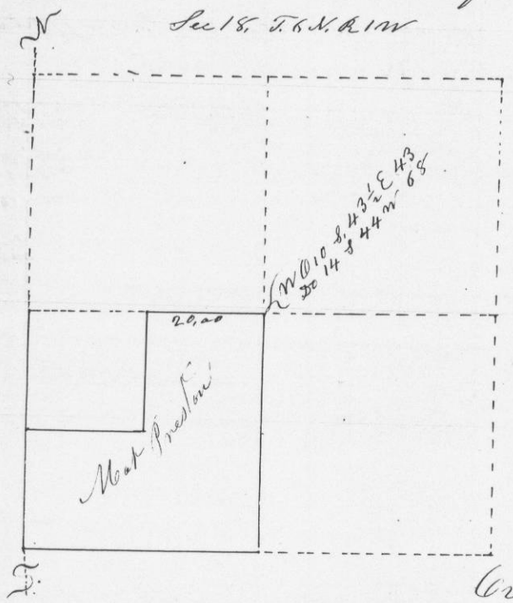
Sec 15. T. 6 N. R 1 W