No. 832

Nov. 20th 1855

Survey for Leonard Coates to wit:
Commence 3,56 chs N. of S.W. corner of S.E.1/4 of N.W.1/4 of section 14 T. 3 N. R. 1 W. 4th Meridian — Thence N. to N.W. corner — E. to N.E. corner — S. 51° W. 25,00 to beginning.
Also. — Commence at N.E. corner — W. 13,57 chs N. 5°14' E 6,35 chs — S. 79° E 13,30 chs — S 4,00 chs to beginning
Courses by true Meridian
Magnetic Variation 8½° E

C. T. Overton Co. Sur
Grant Co. Wis.

No. 832

Nov. 15th 1855

Survey for James Sinn parts of Section 18 in township Six North range one West — shown in the following plat viz:
Sec. 18 T. 6 N. R. 1 W.

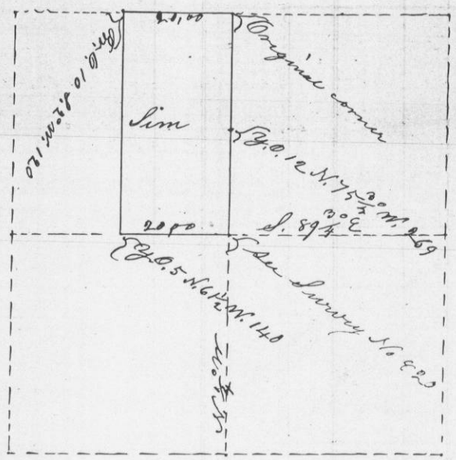

Overton & Co. Surveyors
G. Co. Wis