No. 877

July 8th 1856

Survey for Thomas Curnow the South East quarter of the South West quarter of section Seven in township three North range two West shown in the following plat Viz:

Sec 7 T. 3 N. R 2 W.

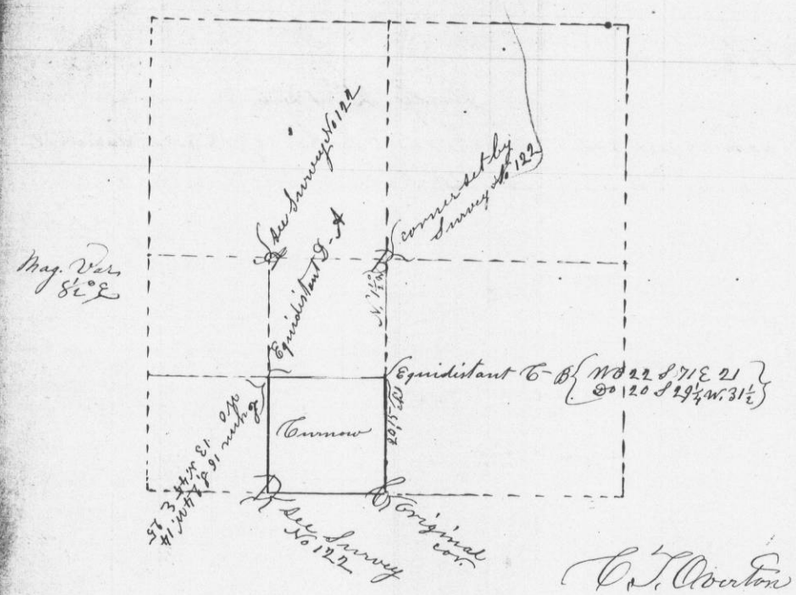

C. T. Overton Co. Sur.

No 878

July 9th 1856

Survey for Moses Calloway the South East quarter of the South East quarter of section twelve in township three North range three West. shown in the following plat.

Sec 12 T 3 N. R 3 W.

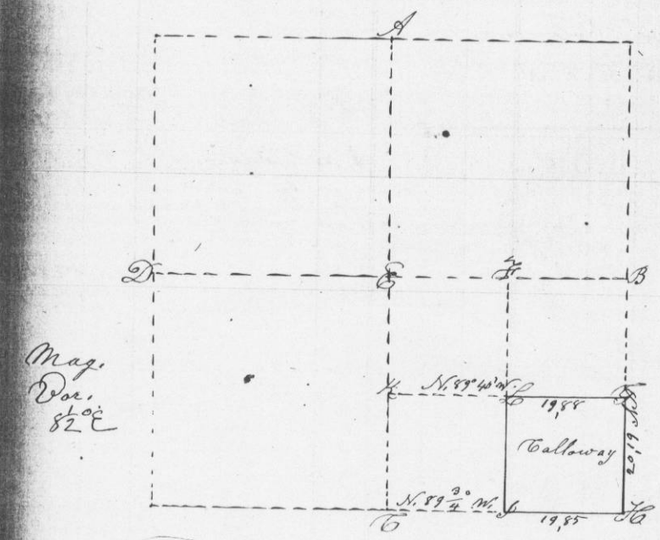

A-B-C-D-H. Original corners

F Equidistant E-B

G " H-B { Br 015 S 20½ W. 44 / Do 10 S 66 W. 87½ }

I " C-H { Br 014 N 74½ E 15½ / Do 26 S 1 E 36½ }

K " C-E

L Intersection of I-K-G { Br 04 S 43½ E 26½ / Br 05 N 66¼ E 36½ }

E " C-H 2-B

C. T. Overton Co. Sur.