No. 908

Survey made for Peter Wentz — the S.E. quarter of the N.W. quarter of Section 3 of Town Three North of Range One West of 4th principal Meridian Made on the 24th day of December 1868 — Samuel Bross and Abraham Brugger duly sworn as chainmen.

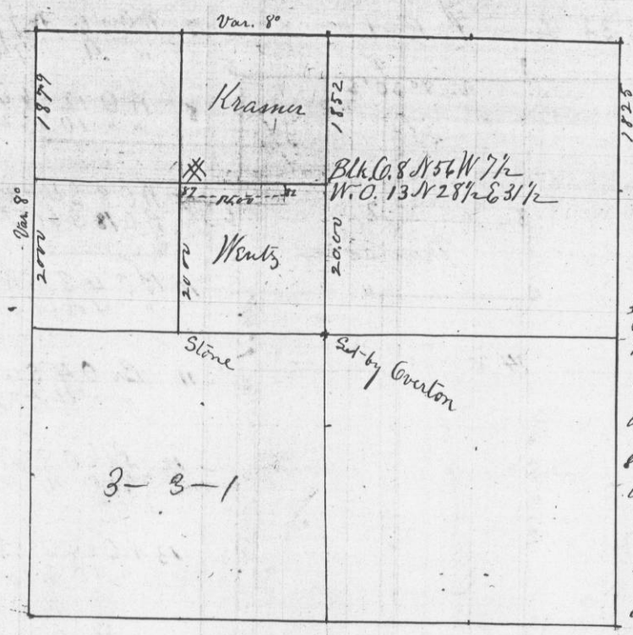

✱ Centre of NW¼ of Sec. 3
Br O12 S10½E89
S.E. Corner of House bears S46½W 231

The cultivated land lying between the true North boundary of SE¼ of NW¼ and the previous line on which the rail fence is built is a strip 14 chains long and 84½ links in width. and Contains 1 18/100 acres

A West
Joel Barber

No. 909

Survey of School House Site in Section 22 Town 5 North Range 4 West of 4th principal meridian. Made on the 30th day of December 1868. Jacob Long and A. E. Morse duly sworn as chainmen.

New bearing tree at Section Corner
3 WO. 5 S 16 W 16

Var. 8°30' E

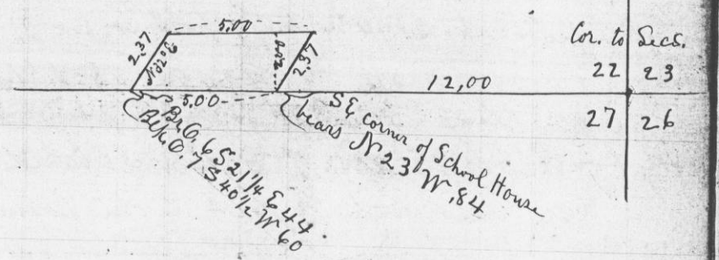

Described as follows Commencing at a point on the Section line between Sections 22 & 27 and 12.00 West of corner to sections 22.23.26 & 27. Thence West along said Section line 5.00. Thence North 32° East 2.37 chains, thence East 5.00 chains Thence South 32° West 2.37 chains to place of beginning, containing one acre,

A true plot and record of Survey

Joel Barber
County Surveyor

{No. 910}

A piece of Land for John Hayden in Sec. 10 Town 3 N. Range 1 West, Commencing at center of Section (WO7 S7E57½) Thence East 16.96 (Red O5 N1¾ W101½) Thence S16½ W6.65 (WO12 N19¼ W147) Thence N82½ W15.20 (RO12 S84¼E27) Thence North 4.42 to place of beginning — Var. 8°26' E

Jacob Kempthorne & Charles Kempthorne duly sworn as Chainmen Dec 21st 1867

Joel Barber
County Surveyor