No. 927

Sec 6 T 5 R 1 West

Survey made for Henry Ottomire on the 1st day of October 1875 of the N W¼ of the S W¼ of Sec 6 T 5 R 1

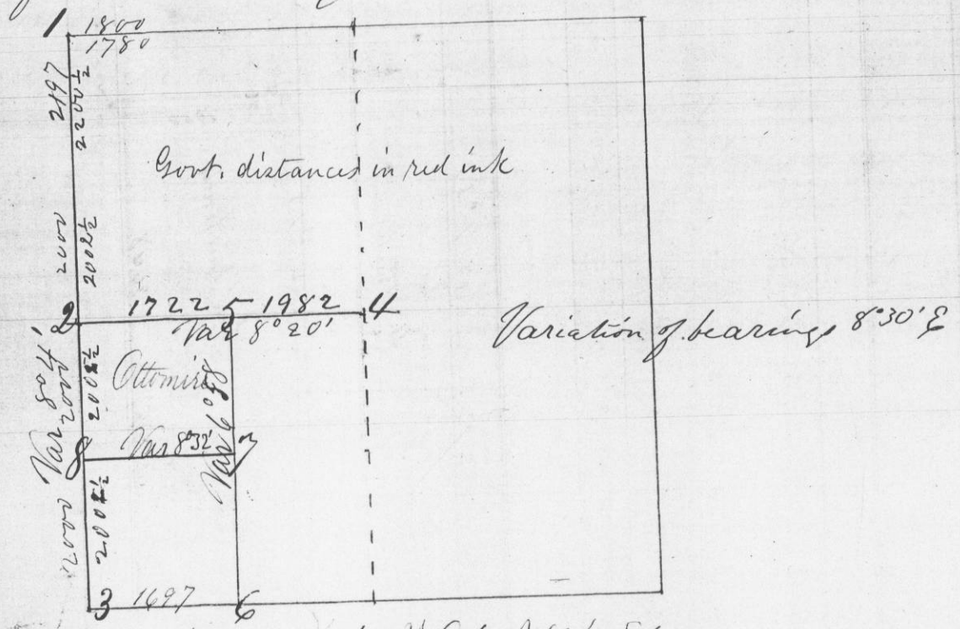

Govt. distances in red ink

1 WC 8 N 53½ W 12½ WC 6 N 64½ E 62
2 WC 4 S 69½ W 35 WC 6 S 28 E 111 New bearings
3 Stone — original corner
4 Ancient Corner Set by Co Surv.
5 BC 4 S 59½ W 13 WC 4 S 55½ E 58
6 Stake set previously
7 WC 29 N 12¾ E 83 WC 5 S 16 E 38
8 BC 6 N 69½ W 72 — BC 3 N 57¾ E 69 — WC 5 N 60½ E 93

Sworn Chainmen Isaac Wagers & L. W. Farnsworth
Recorded and certificate issued Oct. 25th 1875

Attest
Joel Barber
Co Surveyor

No. 928

Sec. 3 T 4 R 5

Survey made for David and James Ballantine in Section 3 T 4 R 5 on the 12th day of Oct. 1875 Set forth in the following plat and notes of Corners

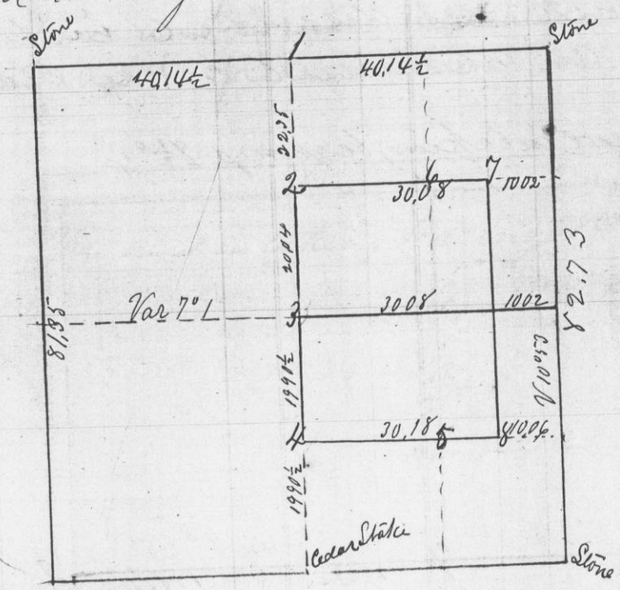

Variation used in taking bearings 8° 30' E

1 Set Stone Soft Maple 3 N 64 W 130½ Soft Maple 3 N 81¼ W 103½
2 Soft Maple 2 N 82¼ E 114 Soft Maple 3 N 77 E 69
3 Set Stone. No trees near
4 Soft Maple S 66 E 109 Soft Maple 3 S 29½ E 215½
5 Soft Maple 3 S 69¼ E 54 Soft Maple 4 S 25 E 126
6 Set a corner — no trees near
7 No bearings taken
8 No bearings taken

Quarter posts set on East North & West sides by resurvey of section lines
East ½ of Section is divided by measurement on corrected East & West lines through centre of Sections and through centre of N E & S E ¼ Sections
Samuel E Steinbrook & Almond Foster Chainmen Recorded and certificate issued Oct 25th 1875 Attest
Joel Barber