Sec 9 T 3 R 4 W.

No. 737

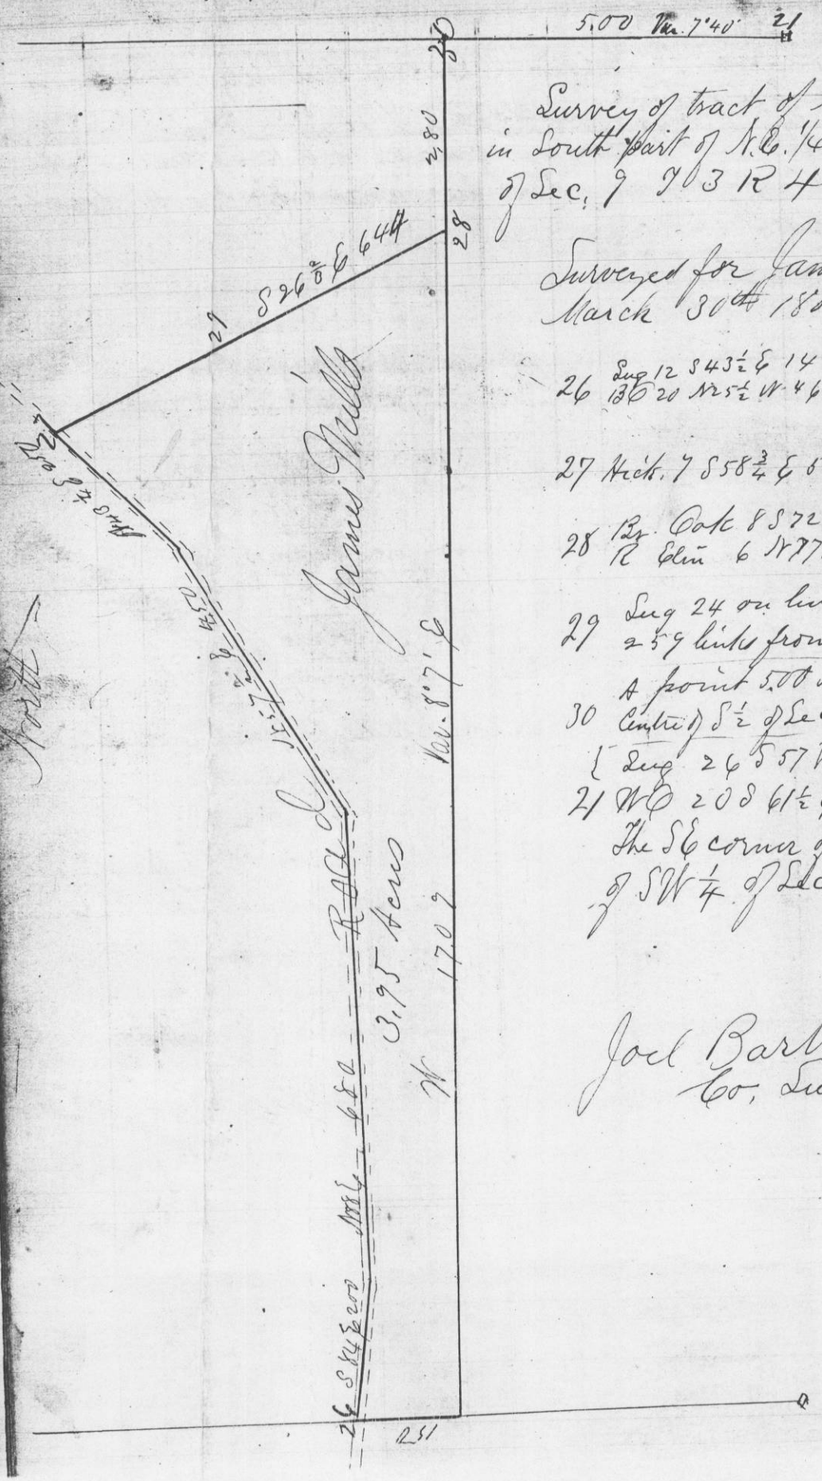

Survey of tract of land in South part of N.E. 1/4 of S.W. 1/4 of Sec. 9 T 3 R 4

Surveyed for James Mills March 30th 1880

26 Leg 12 S 43½ E 14
Bt 20 N 25½ W 46

27 Stick. 7 S 58¾ E 60

28 Br. Oak 8 S 72 W 40
R Elm 6 N 77½ E 23

29 Leg 24 on line
2.59 links from No 27

30 A point 5.00 North of Centre of S½ of Sec. 9-3-4 35/D
Leg 26 S 57 W 16½
21 W 20 00 61½ E 50

The S.E. corner of the N.E. 1/4 of S.W. 1/4 of Sec 9-3-4

Joel Barber
Co. Surveyor

No. 48 Sec. 35. Town 3 North. Range 3 West.

Survey of Lots in S.E. 1/4 of N.W. 1/4 Sec 35. 3. 3. for F. Miller. F. Koll. Wm Mechler and Henry Wallenhorst. F. Miller Jr & Anton Gerhard chainmen. Sworn.

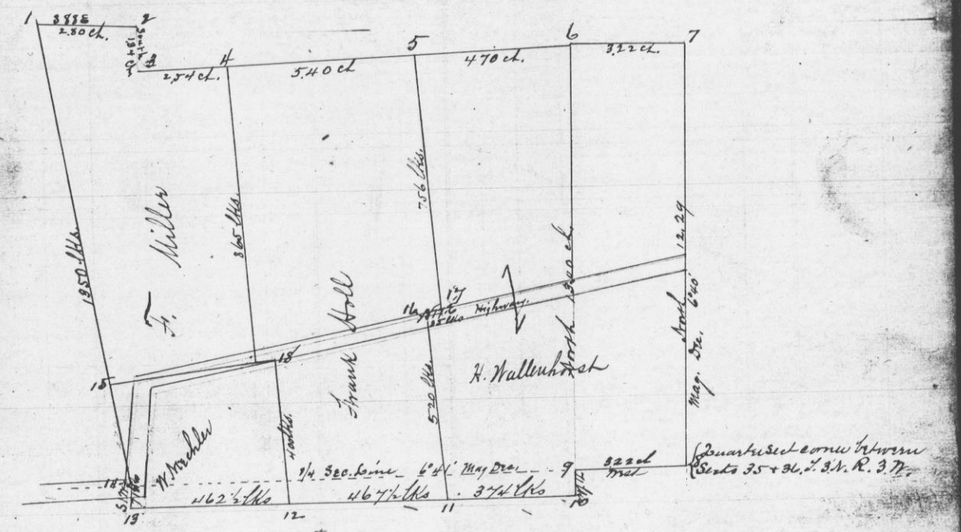

I hereby certify that the foregoing plat is a correct copy of the survey made for the parties above named. Stakes were driven at all corners Excepting Nos. 8 + 18 which it was too stony.

J. C. Scott co. Surv.

Survey made the 14 + 15 days of Nov. 1883.

12.29

14.21
11
1950
444
625
721
4839

1950
12.29
1.21