run thence North at 40.13 chains fell 7 links East of 1/4 Post on West Side of Said Quarter Section
Thence correction South 20.06 1/4 chains & Set 1/16 Section corner { Red Oak 10 N 20 W 139 links
{ Do 10 N 84 1/4 W 74 links
A true record of Notes of Said Survey.
April 26th 1854. Attest John G Clark
County Surveyor.

No 48

Record of Survey made by C. M. Hayden Deputy County Surveyor on the 3rd day of May 1854 of the South 1/2 of S.W. 1/4 of Section 10 Township 3 North of Range 5 West 4th P.M.

Which Said Survey was executed in accordance with an act of the Wisconsin Legislature approved April 2nd 1853. for Oris McCartney. of which Said Survey the following is a true & correct Plat.

S.W. 1/4 of Sec 10 Town 3 North Range 5 West 4 P.M.

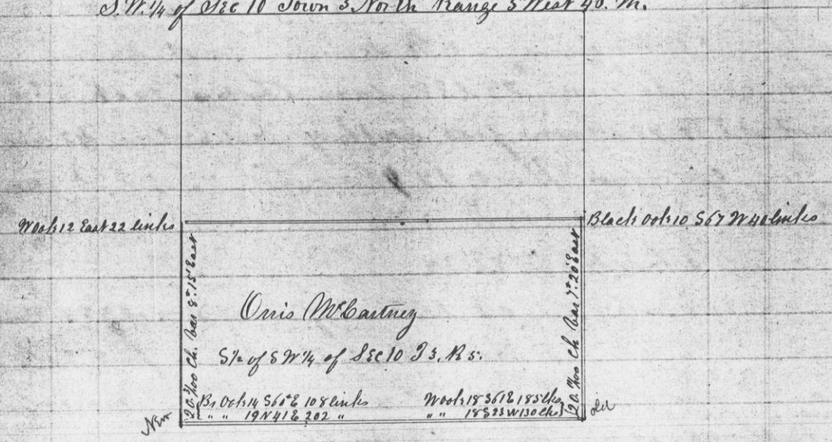

I hereby that the above field notes & plat are correct as copied from the original notes
May 9th 1854. Attest
John G Clark
County Surveyor

Record of Survey made for Raffauf & Geiger by C. M. Hayden deputy County Surveyor on the 29th day of April & 1st day of May 1853 of E 1/2 of N.W. 1/4 & W 1/2 of N.E. 1/4 & W 1/2 of S.E. 1/4 & E 1/2 of S.W. 1/4 of Section 16 Township 3 North of Range 5 West 4th P.M. Which Said Survey was executed in accordance with an act of the Wisconsin Legislature approved April 2nd 1853. of which Said Survey the following is a true & correct plat representing the length of lines. Variation and the bearing trees at their respective corners. Alexander Pollinghorn and William Burgess chainmen first duly sworn.

Section 16 Township 3 North Range 5 West of the 4th P.M.

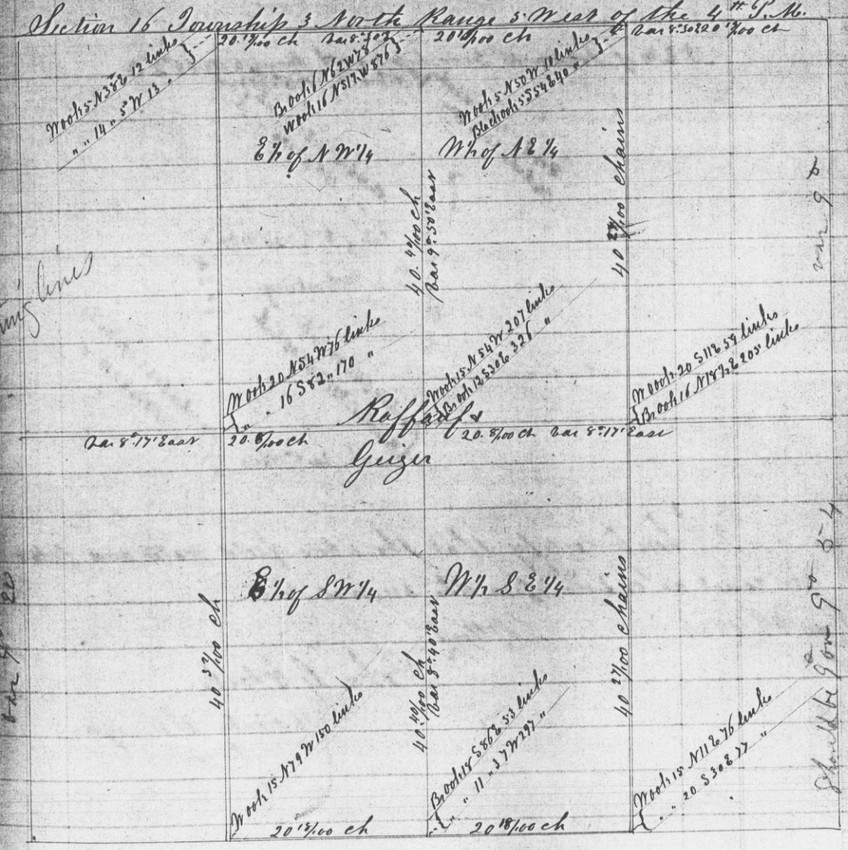

I hereby certify that the above field notes and plat are correct as copied from the original notes & plat.
May 9th 1854 Attest
John G Clark.