No 50

Record of Survey of E½ of N E ¼ of Section 16 Township 3 North Range 5 West made for Oris McCartney by C. N. Hayden Deputy County Surveyor on the 29th day of April and the 1st day of May 1854. made executed in accordance with an act of the Wisconsin Legislature approved April 2nd 1854. of which said Survey the following is a true and correct plat representing the length of lines the corrected variations of the same and also the bearings at the several corners Alexander Pettinghorn and William Burgess chainmen first duly sworn

N E ¼ of Section 16 Township 3 North Range 5 West 4th P. M.

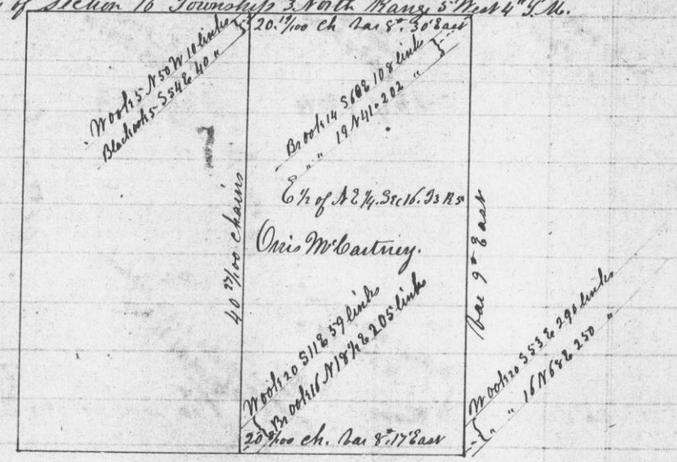

I hereby certify that the above field notes and plat are correct as copied from the original notes

May 9th 1854

Attest

John G Clark

County Surveyor.

No 51

Record of Survey made by C. N. Hayden Deputy County Surveyor on the 2nd & 3rd days of May 1854 of the N W ¼ & W½ of N E ¼ & W½ of S E ¼ & N E ¼ of S W ¼ of Section 15 Tom 3 North of Range 5 West of the 4th Principal Meridian which said Survey was executed in accordance with an act of the Wisconsin Legislative approved April 2nd 1853 of which Survey the following is a true & correct plat. Made for Oris McCartney.

Section 15. Township 3 North Range 5 West 4th P. M.

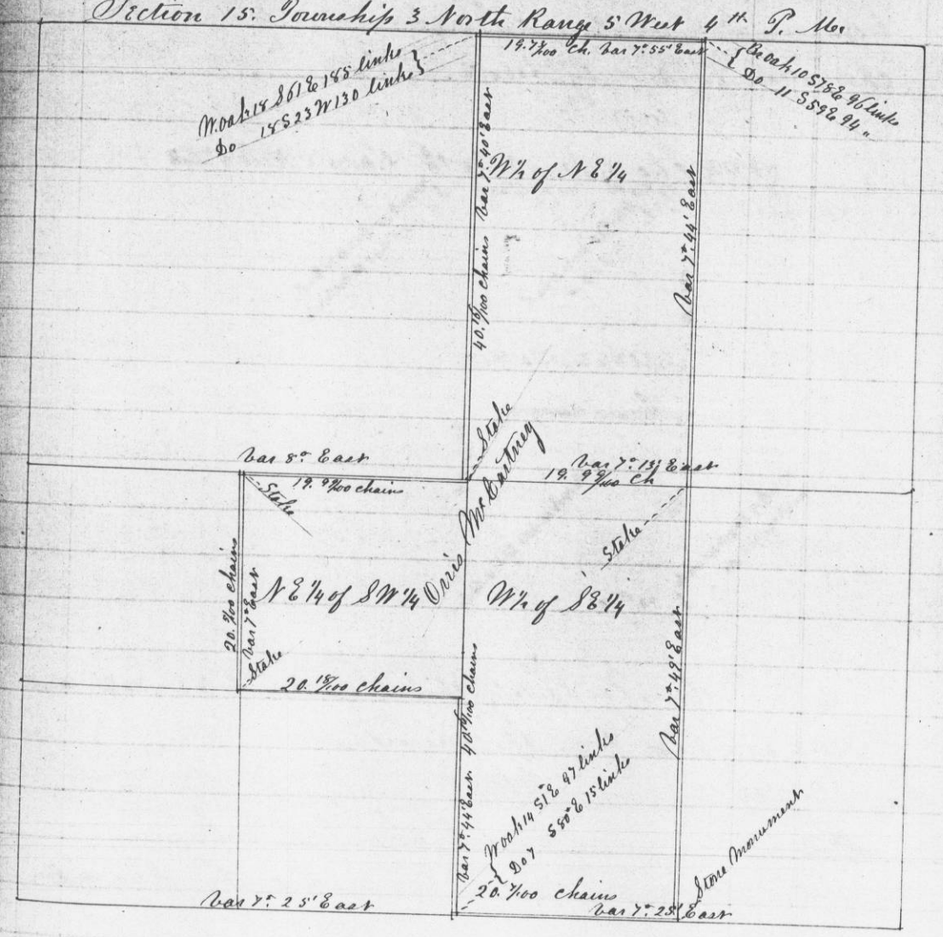

I hereby certify that the above field notes & plat are correct as copied from the original notes

Attest

Recorded May 9th 1854.

John G Clark