No 58

Record of Survey of Lot in N.E corner of N.W. of S.E 1/4 of Section 1 Town 4 North Range 5 West for Carter Hiscock by E. W. Hayden Deputy County Surveyor April 10th 1854. Of which let the following is a correct plat representing the length of the boundary lines thereof the corrected bearings & the land marks at the respective corners Mark Hadley & John Clark chainmen first duly sworn




A true & correct record of the said Survey as copied from the original field notes.

May 10th 1854.

Attest

John G Clark
County Surveyor

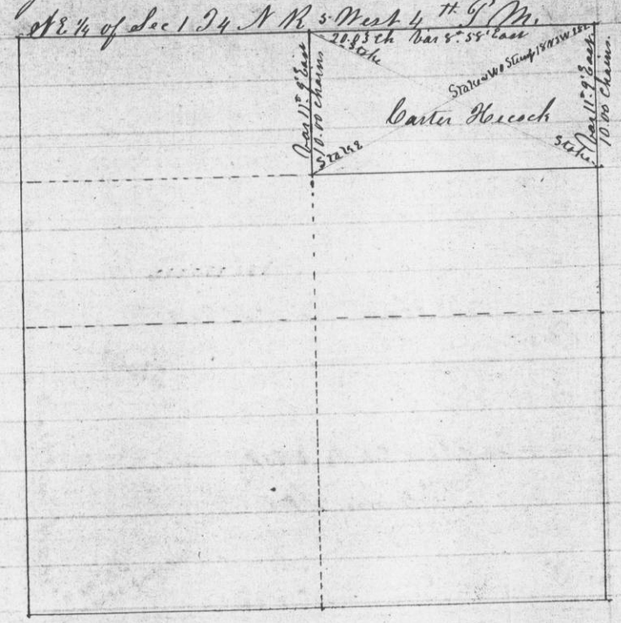

No 59

Record of Survey made by H. A. McNair Deputy County County Surveyor for John A Shearer in Section 24 Town 6 North Range 5 West. May 5th 1854.

Commencing at center post of said Section: thence run South bearing 8° 30' East. at 40.37 chains intersect South boundary of Section 13 links West of Quarter Section corner. Thence corrected North at 20.184 chains set post for 1/16 Section corner. Then from Center post place of beginning run West bear 8° 30' East at 40.62 chains intersect West boundary of Section 5 links South of 1/4 Section corner: thence corrected East 20.31 chains & set 1/8 Section post. Then from 1/4 corner on West side of said Section South, bar 8° 30' East at 40.38 chains intersect South boundary of Section 4 links West of ~~1/4~~ Section corner: Thence corrected North 20.19 chains and set 1/16 Section corner ~~North corrected 20.19 & Set temporary 1/16 Section corner~~

Then from corner of Section 23.24.25.26 Run East at 40.20 chains fell 23 links north of 1/4 Section corner. Thence corrected West 20.10 chains & set post for 1/8 Section corner. ~~Thence corrected North 20.19 chains and set temporary 1/16 Section corner.~~ Thence run North bearing 8° 30' East at 40.13 chains fell 14 links East of 1/8 Section corner. Thence South corrected 20.06½ chains and set temporary 1/16 Section corner. Then from 1/16 Section corner on the West side of said Quarter Section at 20.30 fell 6 links North of temporary ~~co~~ 1/16 Section corner. at 40.46 chains intersect at 1/16 Section corner. Thence West corrected 20.23 chains & set post for 1/16 Section corner.

A true copy of notes of said Survey

Recorded May 10th 1854

John G Clark
County Surveyor