No 73

Survey made for William J. Emmon by Solomon Goodrich Deputy County Surveyor May 4th 1854 of the S½ of the S½ the N½ of the N½ also ten acres in the South side of the S.E. ¼ of S.W. ¼ of Section 24 Township 3 North Range 3 West 4th P.M. Robert Gerard and James Edwards chainmen and James Richards flagman first duly sworn.

Section 24. Township 3 North Range 3 West

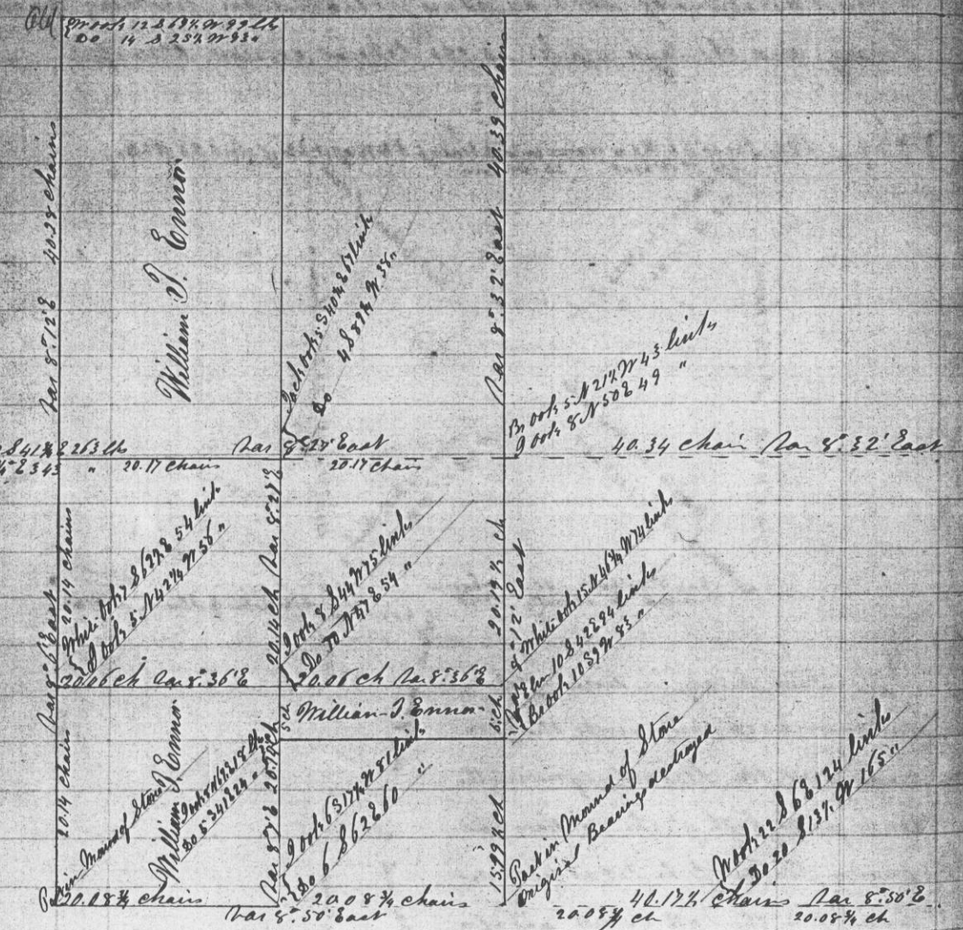
William J. Emmon
40.34 chains
Bar S 5°12' E
Bar S 5°32' East
40.34 chains
Bar S 5°32' East
20.17 chains
20.14 chains
20.06 ch
20.08¾ chains
Bar S 5°50' East
20.08¾ ch
46.17¾ chains
Bar S 5°50' E
20.08¾ ch
Bar S 5°36' E
Bar S 5°36' E
