No 77

Survey made for A. A. Bennett May 8th 1854 by Solomon Goodrich Deputy County Surveyor of the N E ¼ and of the N W ¼ of the S E ¼ of Section 23 Township 4 North Range 6 West 4th P. M. William Curtis & Washington Scott first duly sworn as chainmen.

Section 23 Township 4 North of Range 6 West of 4 Principal Meridian

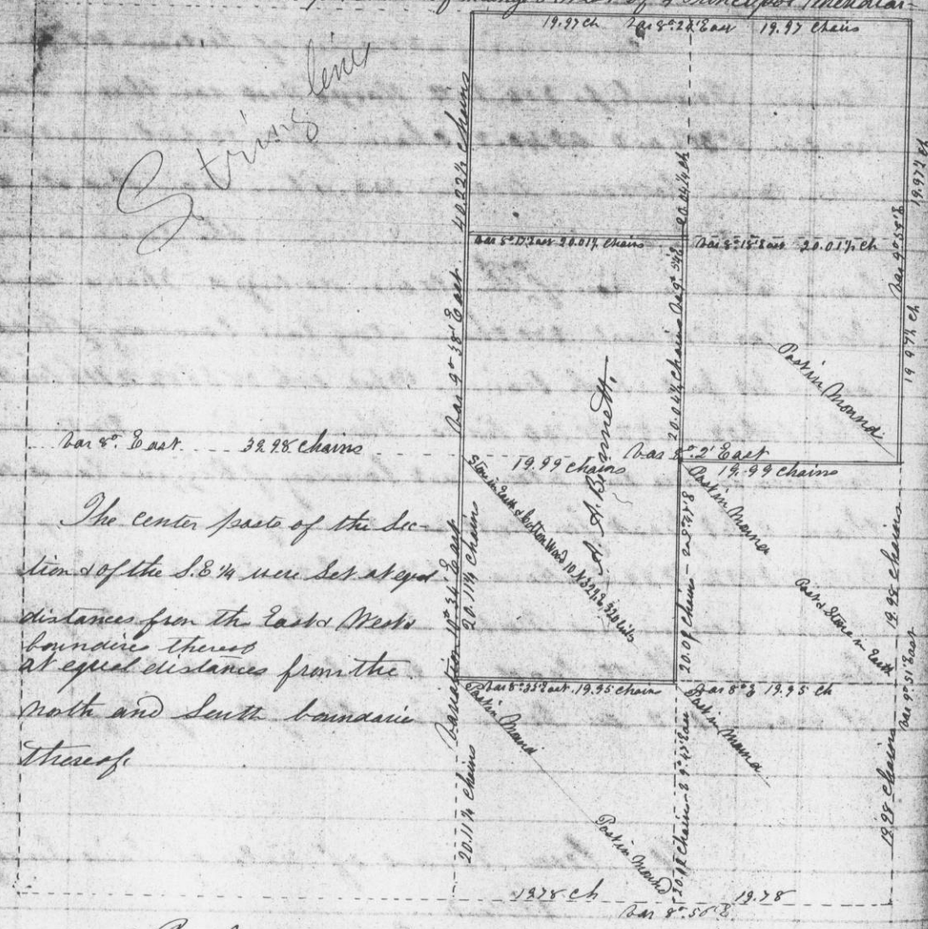

The center posts of the Section & of the S E ¼ were set at equal distances from the East & West boundaries thereof at equal distances from the North and South boundaries thereof

I hereby certify that the above is a correct copy of the original notes of said Survey.

Attest

Recorded June 8th 1854 John G Clark
County Surveyor

No 78

Survey made for William Curtis May 9th 1854 by Solomon Goodrich Deputy County Surveyor of the S½ of the S E ¼ of Sect 23 Town 4 North Range 6 West. William Curtis and Washington Scott chainmen first duly sworn

S½ of S E ¼ of Section 23 Township 4 North Range 6 West

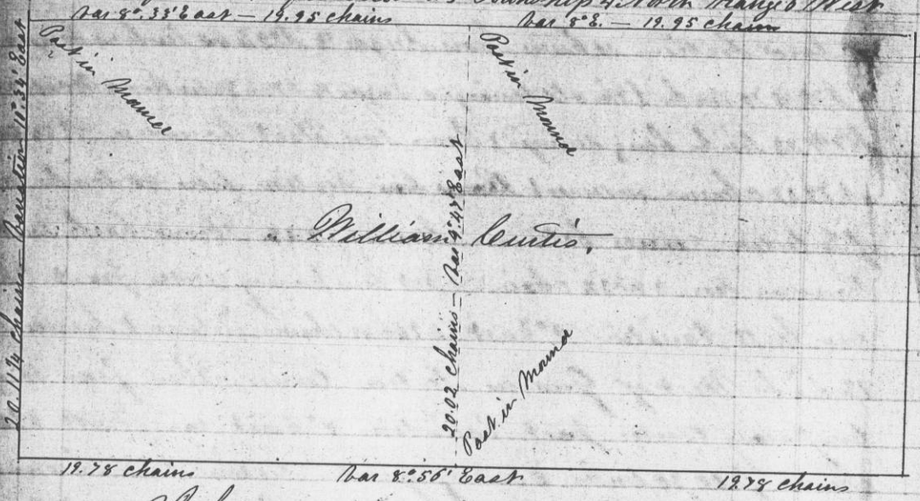

I hereby certify that the above and foregoing is a correct copy of the original field notes of said Survey.

Attest

Recorded June 11th 1854 John G Clark
County Surveyor