No. 87

Survey made on Section 27 Township 5 North Range 1 West June 24th 1854 by Solomon Goodrich Deputy County Surveyor for the heirs of James Elliot deceased George M. Morris and John Dubel Chainmen first duly sworn.

Section 27 Township 5 North Range 1 West

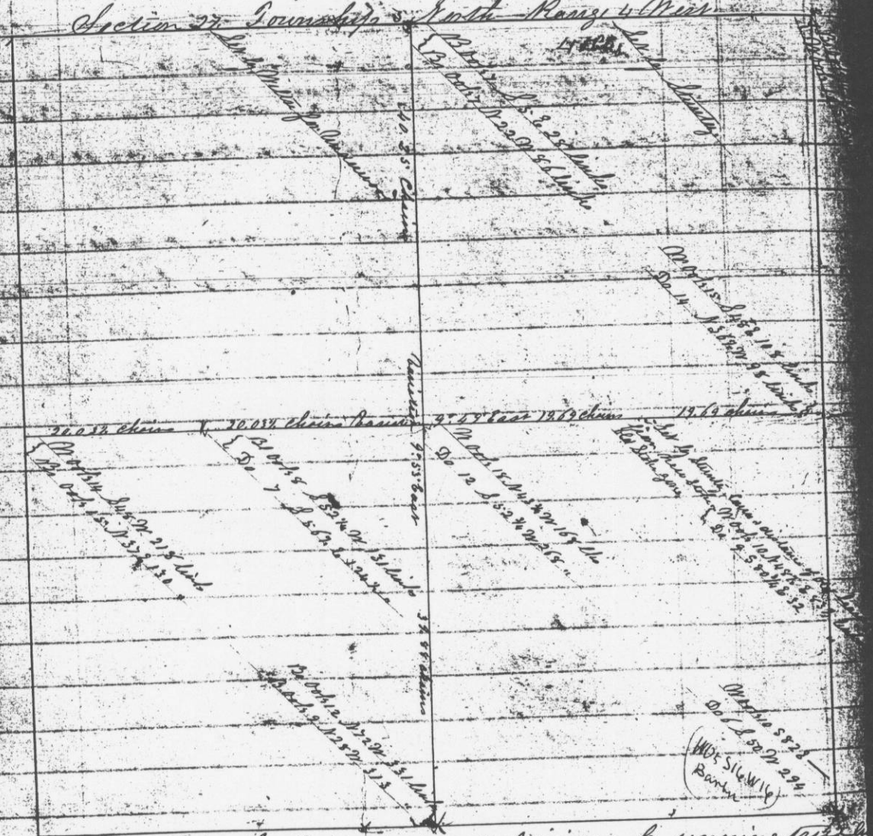

The said Section 27 was re-subdivided by running lines from East to West & from North to South through the same & the above plat represents the true length of such lines as were measured & the variation of such as were retraced & the bearings at the several corners that were established or reestablished

A true Record of Notes of said Survey

Attest

Recorded July 17th 1854.

John G. Clark.
County Surveyor

No. 88

Survey made for Ben Le Cardman by Solomon Goodrich Deputy County Surveyor in Township 6 North Range 1 West July 10th 1854.

Corner of Sections 11 & 12 on 4th Meridian reestablished new bearings White Oak 5 S 45 W 44 links White Oak 5 N 40 W 56 links. 1/4 Section Corner between same Sections old bearings being nearly gone Set Stake & Stone at 1/4 Section Corner At 1/16 Section Corner between Sections 23 & 24 no old bearings being gone Stake & new one made bearing White Oak 10 N 41 W 89 links

A true Record of Notes of said Survey

Attest July 17th 1854. John G. Clark County Surveyor

31
162
7

16

19.83
19.69
.24