No. 96

Survey made May 15th 1854 in Section 2 Township 4. Range 6 by Solomon Goodrich Deputy County Surveyor of the S.W¼ of the S.E¼ for Henry Eralich and of the S.E¼ of S.W¼ for Anson Thomas. & of the S.W¼ of the S.W¼ for Becheith & of the W½ of the N.W¼ for Mrs M. L. Sargent & of the W½ of the N.E¼ for Mrs P. A. Sanders. & of the N.E¼ of the N.E¼ for William W Richard. & the S.E¼ of the S.E¼ for Ephraim Smith. William W Howard and Warren C Thomas Chainmen first duly Sworn.

Section Two. Township 4 North. Range 6 West

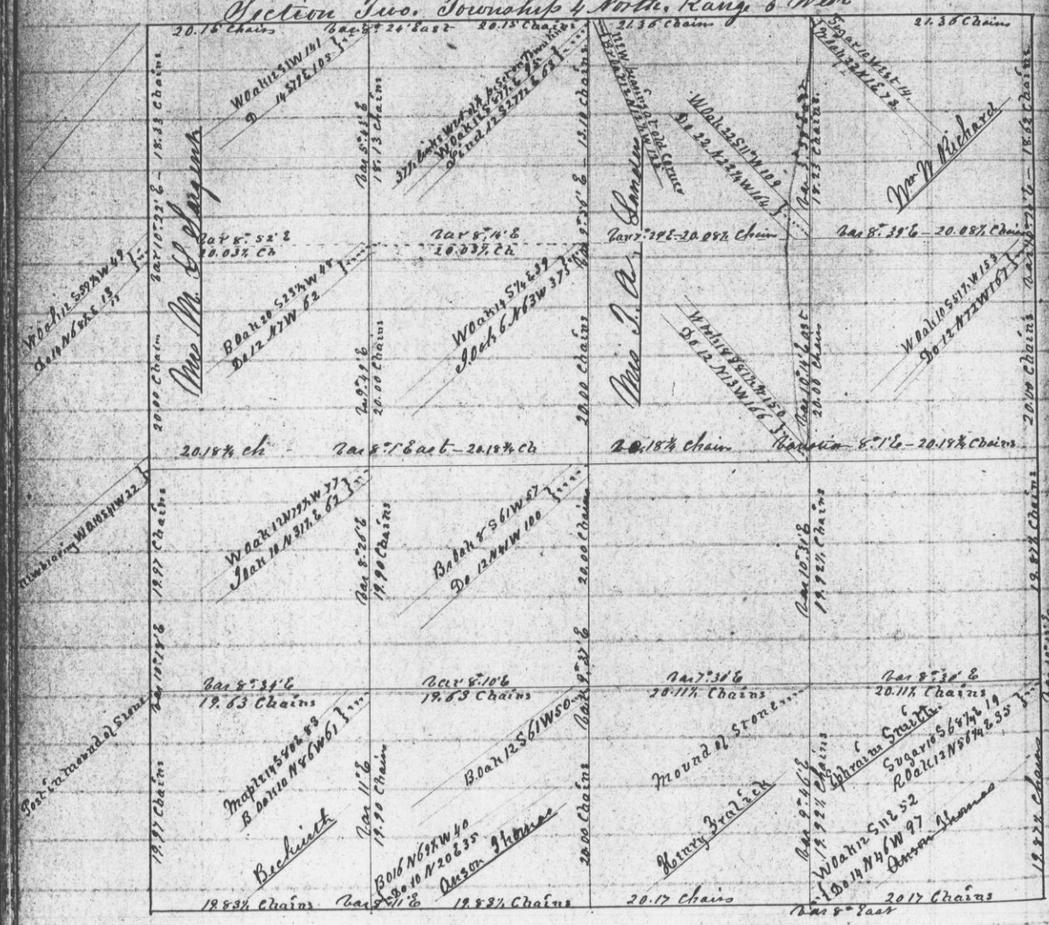

I hereby certify that the above is a correct record of the Original Notes of said Survey.

John G Clark
County Surveyor
Grant Co. Wis.

Recorded August 10th 1854.

Guess this refers to T6 R6

Survey made for Isaac Cranston to Establish the ¼ Section Corne between Sections 30 & 31 Township North of Range West Old bearing north of the line being cut back new one in line thereof. N 0 deg 12 M W. W 66 links. Solomon Goodrich Deputy County Surveyor. the Surveyor. April 8th 1854

Recorded Sept 1st 1854.

A true Record of notes of said Survey.

Attest
John G Clark
County Surveyor.

No. 98.

Survey made on Section 2 Township 4 North of Range 5 West April 12th 1854 by Solomon Goodrich deputy County Surveyor of the N.W¼ for Joseph Wren and of the S.W¼ for Christopher Dorothy Henry Eralich and William J Richards Chainmen first duly Sworn.

Commencing 3.51 chains South of past set for quarter Section corne on West side of said Section 2 on Range line and set for Section 12 West of said Range line. thence run East Variation 9° 30' E At 82.71 chains intersect Section line at ¼ Section corne. Thence West on said line 40.00 chains and set temporary post for quarter Section corner.

Thence North from quarter post on South boundary of said Section 2 Variation 9° 30' E. At 39.83 chains intersect quartersections line 60 links East of temporary quarter Section corner. At 72.10 chains intersect Section line 148 links East of quarter Section corner. Thence South corrected 10° 45' East at 39.55 chains set post in mound for quarter Section corner