No 106

Survey of a Lot lying in the S.E¼ of S.W¼ of Section 26 Township 3 North Range 3 West made for William T. Emmes August 21st 1854 by Solomon Goodrich Deputy County Surveyor.

Commencing ~~13.00~~ 12.93 chains West of ¼ Section corner South of center of said Section Thence West variation 8° 22' East 2.17½ chains to ¼ Section corner Thence South Var 8° 14' East 9 links Thence Var 7° 24' E S 25° E 74 links to Center of Potosi and Platteville Road Thence N 65° E 2.91 chains along said Road to place of beginning containing ~~1 1/12~~ 1.54/100 rods.

A true Record of Notes of said Survey Attest

John G. Clark
County Surveyor

Received September 7th 1854.

No 108
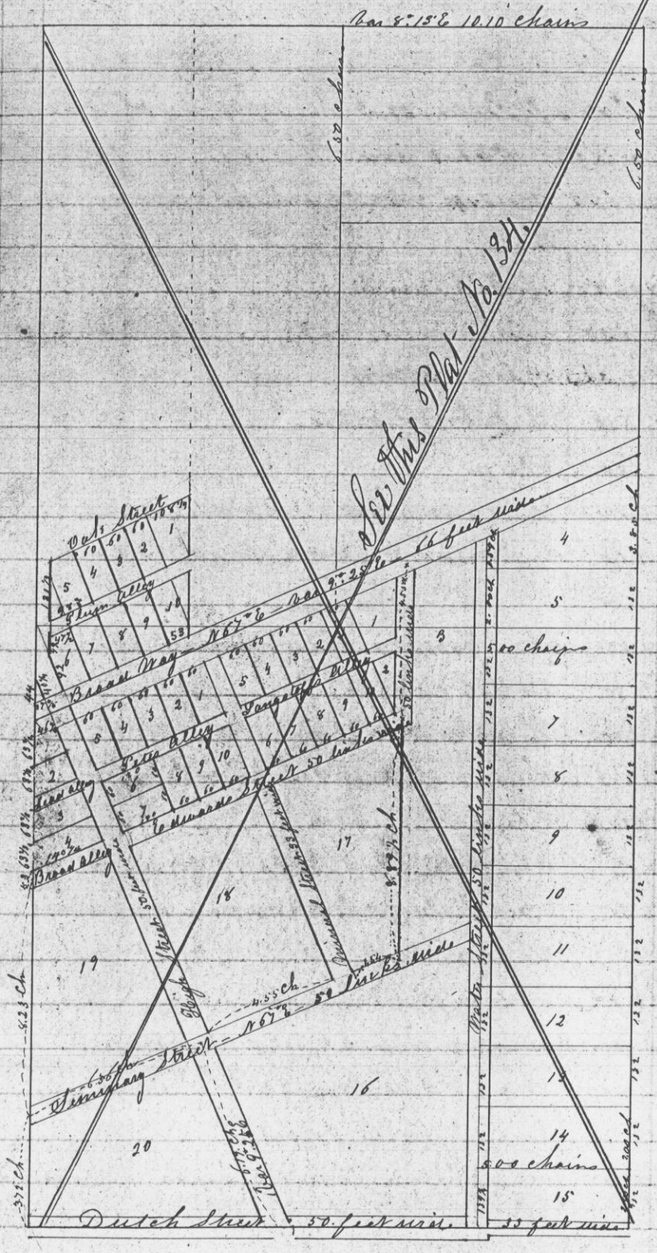
Survey of a Town called Bezeen made August 1854 by Solomon Goodrich Deputy County Surveyor for William T. Emmes & lying in the East ½ of S.W¼ of Section 26 Township 3 North Range 3 West