Survey made on section 7 in town 5 north, of range 4 west May 25th 1854 by C. M. Hayden Deputy County Surveyor of the E. 1/2 of S. W. 1/4 & S. W. 1/4 of S. E. 1/4 for Charles Addison.
Moses Burns & Alfred Dubel, Chainmen
Section 7 town 5 range 4 west

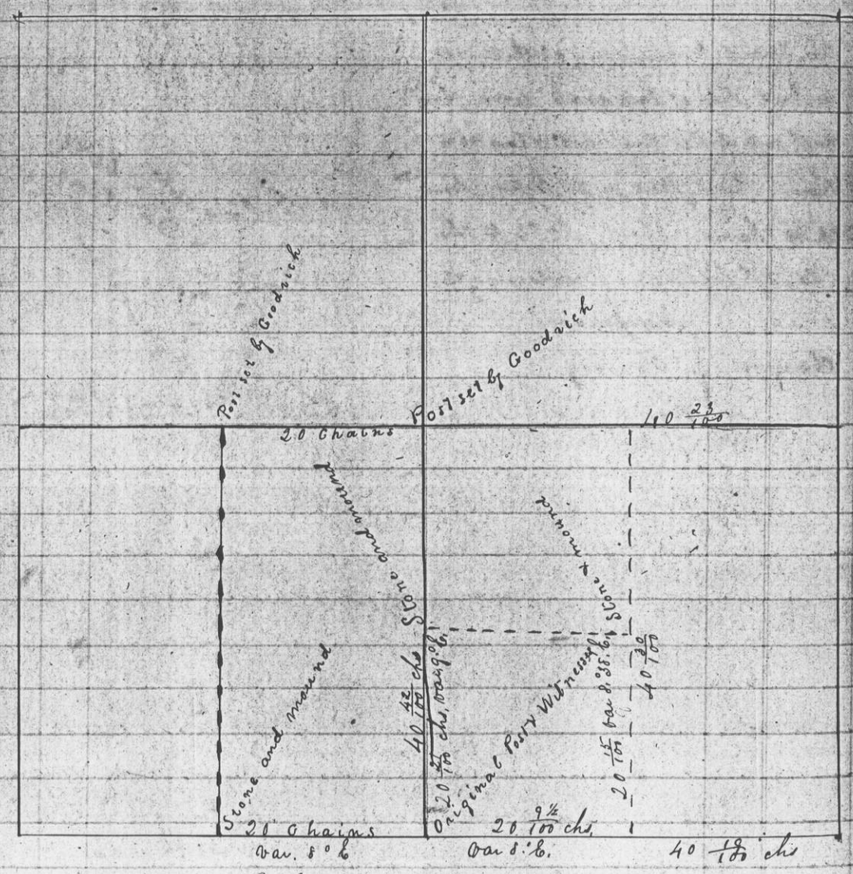

I hereby certify that the above is a correct copy of the original notes & diagram of said Survey.
Recorded September 28th 1854. Attest

John G. Clark.
County Surveyor

Survey made on Section 32 Township 4 North of Range 3 West September 26th 27th & 28th 1854 by Solomon Goodrich Deputy County Surveyor of the S. E. 1/4 of N. W. 1/4 & N. E. 1/4 of S. W. 1/4 for Mathias Cline. John P. Schiegen & John Pink chainmen.

Section 32. Township 4 North Range 3 West

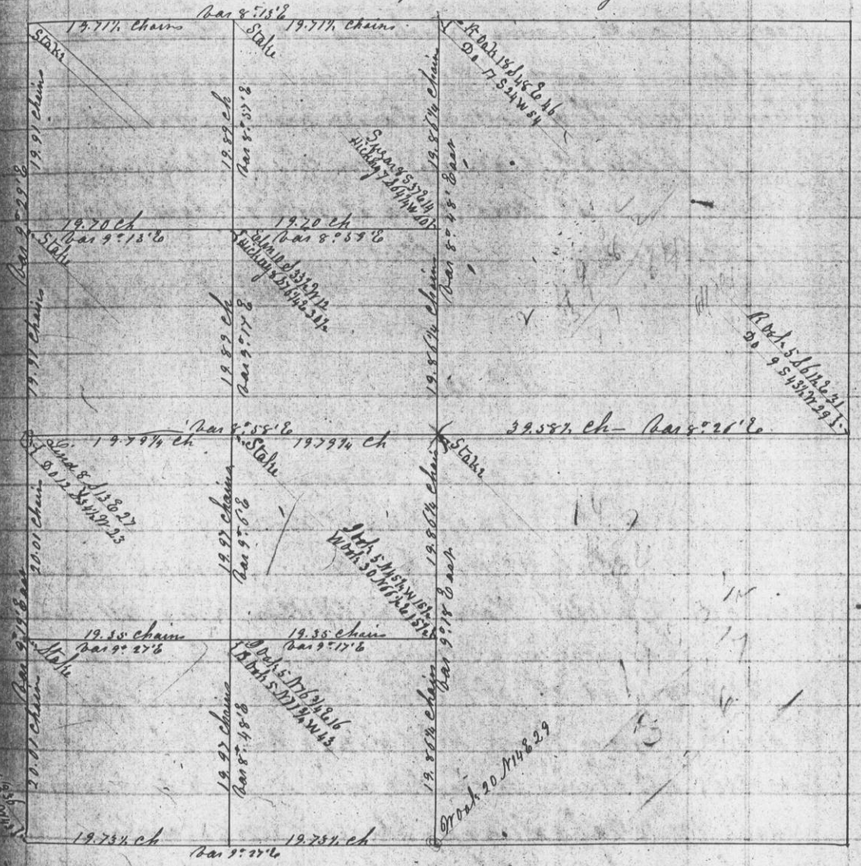

I hereby certify that the above is a correct copy of the original notes & diagram of said Survey.
Attest
Recorded September 28th 1854

John G. Clark.
County Surveyor.