No. 145

Survey made for Thomas Gurney of E½ of W½ & S½ of the S.W¼ of N.W¼ of Section 24. Town 3 Range 5 by C Whitney Hayden County Surveyor, March 17. 1857. Also the W½ of S.E.¼ of same section for Thomas Burrows & E½ of S.E.¼ for Elijah Gruen & S.W¼ of N.E.¼ & S.E.¼ of N.W¼ for Chester Burrows, & N.W¼ of N.W.¼ & N½ of S.W.¼ of N.W¼ for Geo. Williams March 18. 1857.

Section 24. Town 3 Range 5 West

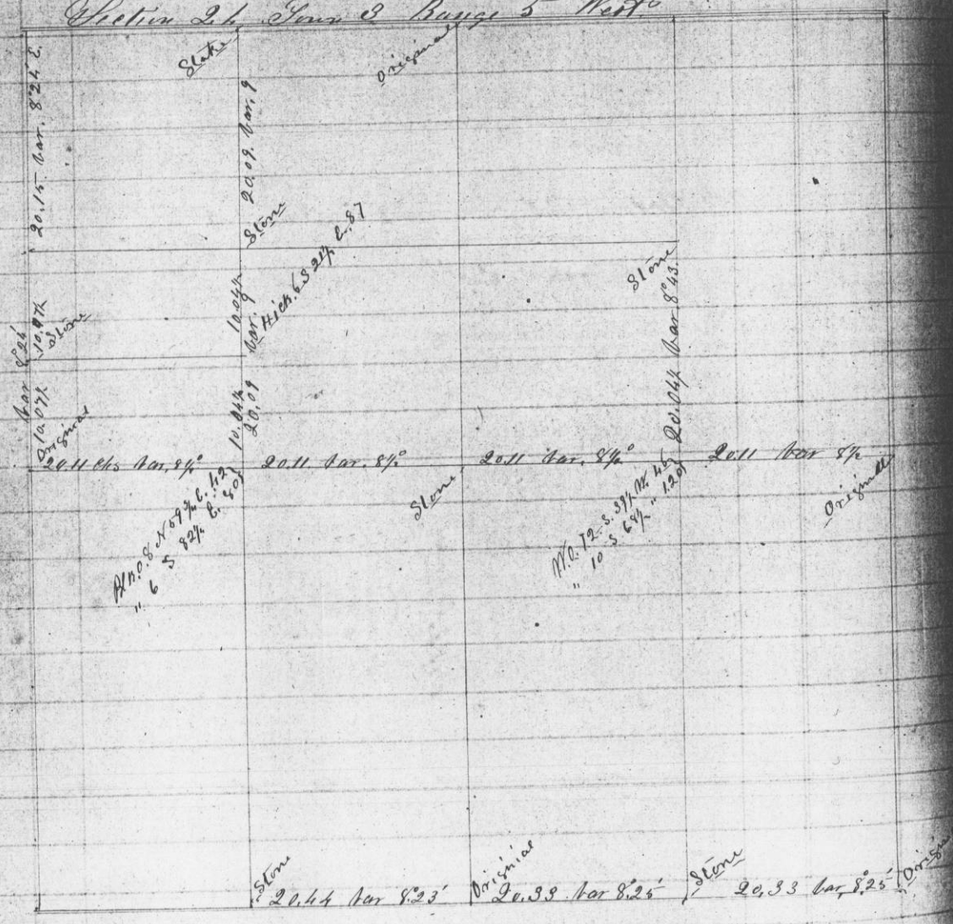

A true copy of the field notes of said Survey

Attest C Whitney Hayden

RECORDED MARCH 31, 1857 County Surveyor

No 146

Survey made for Thomas Gurney of E½ of N.E.¼ of Section 36. Town 3. Range 5; the N.W.¼ & W½ of N.E.¼ of Section 31. Town 3 Range 4. West. March 19. 1857. by C Whitney Hayden County Surveyor.

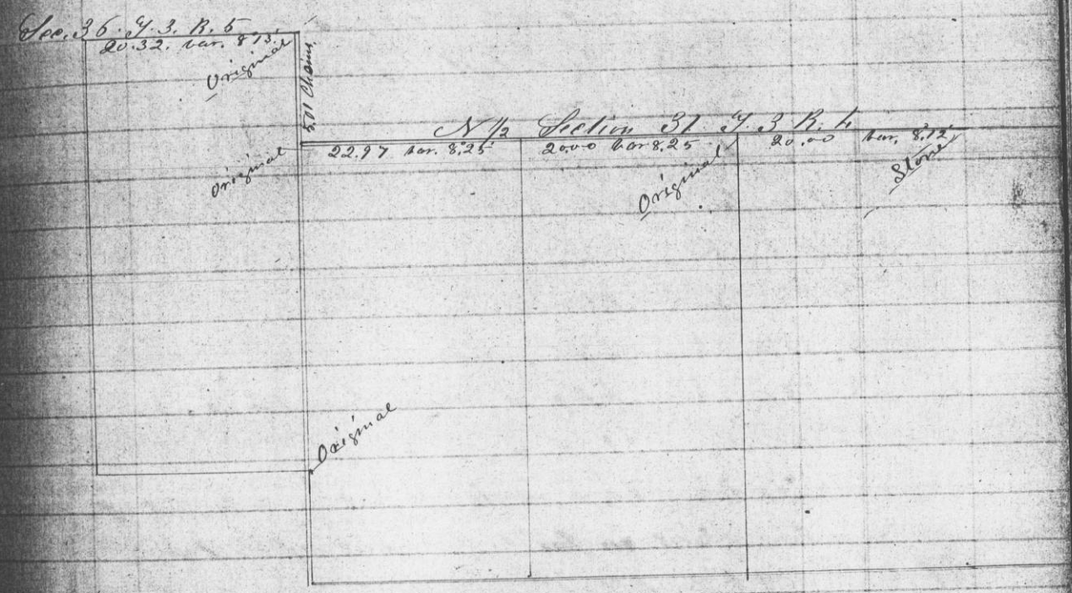

A true copy of the field notes of said Survey

Attest C. Whitney Hayden

County Surveyor

Recorded March 31. 1857