No. 158

Survey made for Brady Walker & Lewis Arnold by Wm N. Reed Dept Co. Surveyor, in Section 26 Town 8 Range 3 West S. Wm. Christ & Henry Kester Chainmen Duly Sworn

From N.W. Corner of said Section 26. run E. Var. 9½° E. and at two chs. intersected 31 links to the left of ¼ Post – Back Corrected Var. 8°29' E. at 2000 Set post, thence from a point 12.77 West of last point, run S 40° E. 5.50 chains

Thence S 26° 30' E – 7.50 chains
" " 72° W. 7.34 Do.
" N 12° E. 5.50 Do.
" N 36 W. 9.38 Do.
" East – – 4.43 Do. to place of Beginning lacking 14 links & Containing 5.02 Acres Made Apr. 25 – 1857

A true Copy of the field Notes of Said Survey

Attest C. Whitney Hayden
Co. Surveyor

Recorded June 16. 1857

No. 159

Survey for Peter Day in Section 2 Town 1 Range 2 by Wm N. Reed, Made Apr 15. 1857

No. 2 Town 1 Range 2 West.

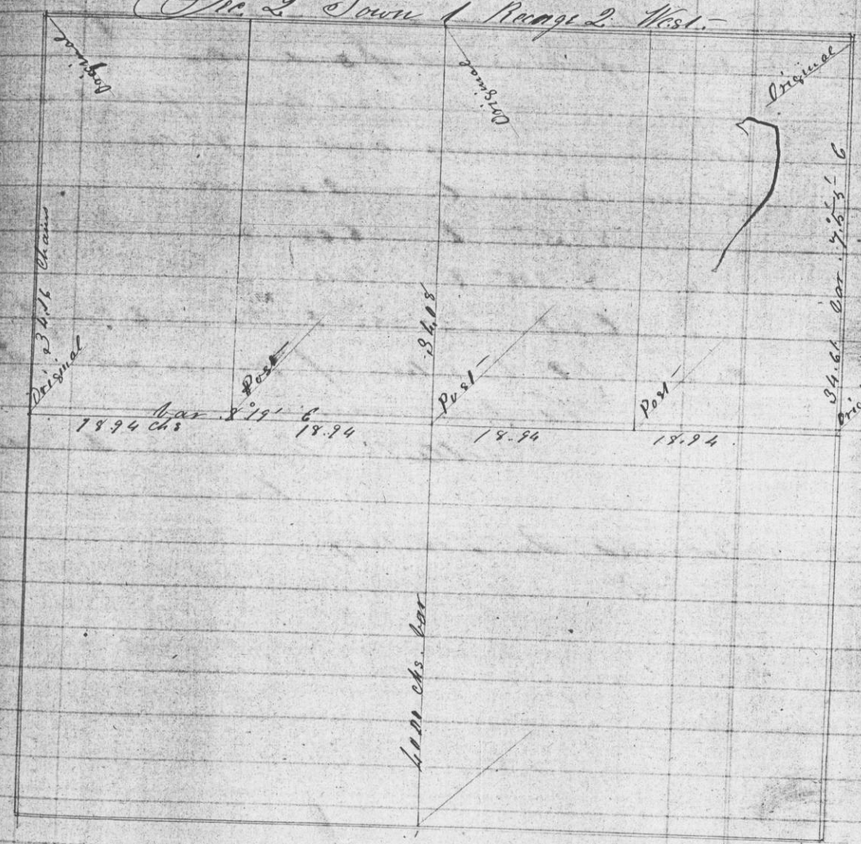

A true copy of the field notes of said survey

Attest C. Whitney Hayden
County Surveyor

Recorded June 16 1857