No. 164

Survey made June 6 & 5th 1857 by James Wilson Jr. Deptc. Co. Surveyor of the N.E. 1/4 of S.W. 1/4 & S. 1/2 of S.W. 1/4 of Section 16 & N. 1/2 of N.W. 1/4 of Section 21. Town 4. Range 5 W. for D. Oliver 74 R 5

The following is a true Plat & Copy of the field notes of said Survey

Attest C. Whitney Hayden
Co. Surveyor

Recorded July 27. 1857

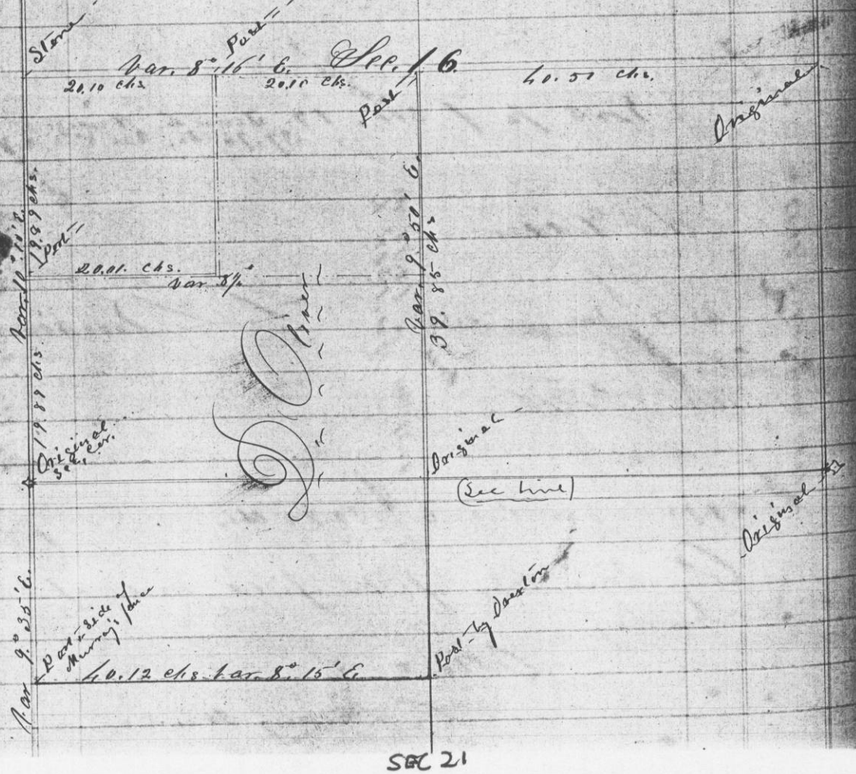

No. 165

Survey made by James Wilson Jr. Deptc. Co. Surveyor June 6. 1857. of the South half of South West quarter of Section twenty one Town four Range five West. Made for John Longmire

21 — 4 — 5

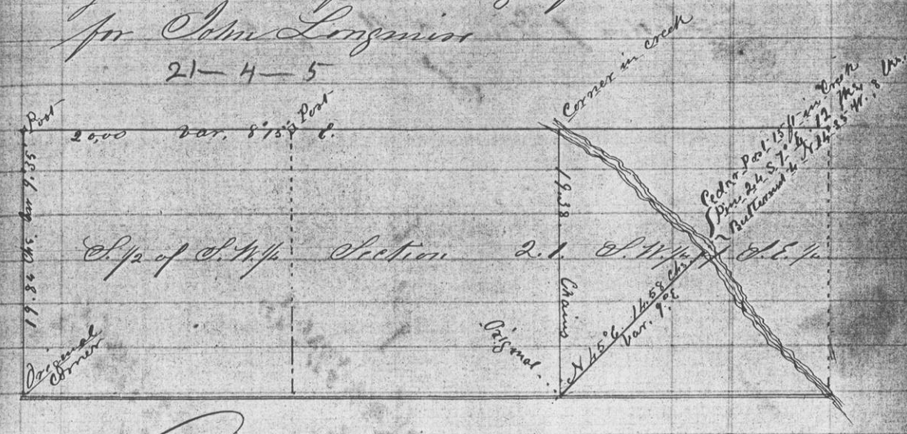

A true copy of the original notes
Attest C. Whitney Hayden
Co. Surveyor

Recorded Dec. 23. 1857