No. 166

Survey made June 23 1857 by James Wilson Jr. Dept. Co. Surveyor in Sec. Seven Town five, Range five West.

Section 7 Town 5 Range 5

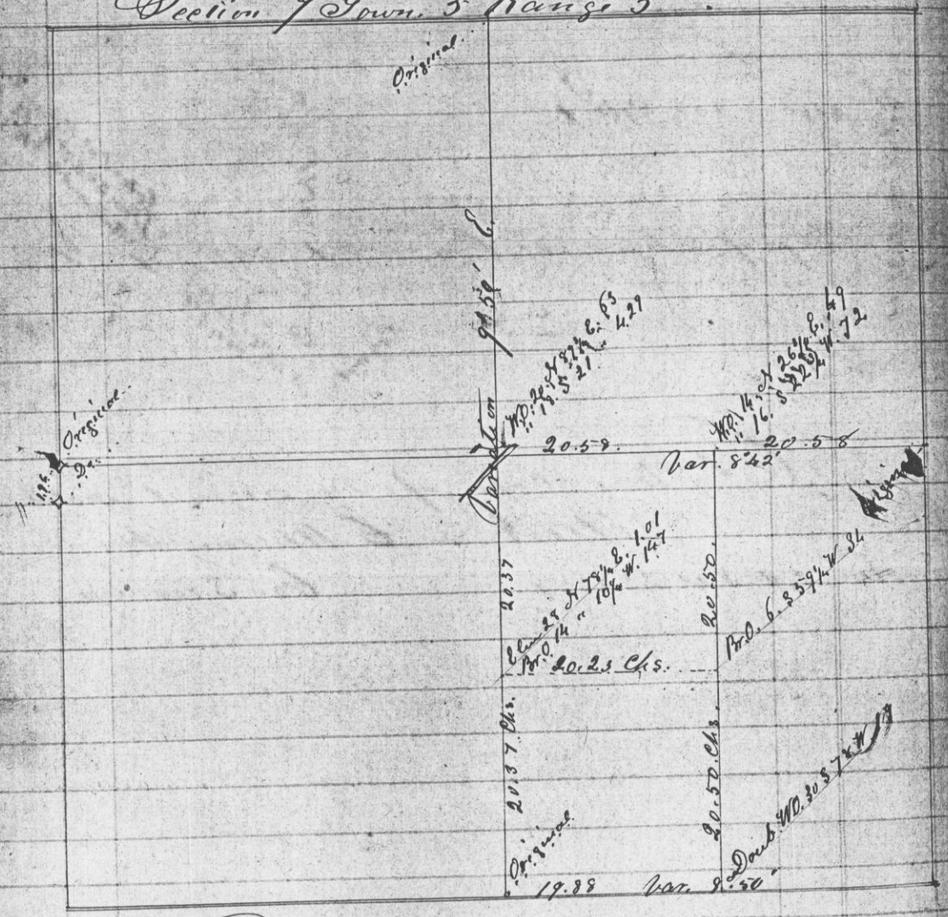

A true Copy
Attest C. Whitney Hayden
Co. Surveyor
Grant Co. Wis.

Recorded Dec. 23. 1857

No. 167

Survey made by James Wilson Jr. Dept. Co. Surveyor June 20 1857 in Sections nine & ten Town five Range five West.

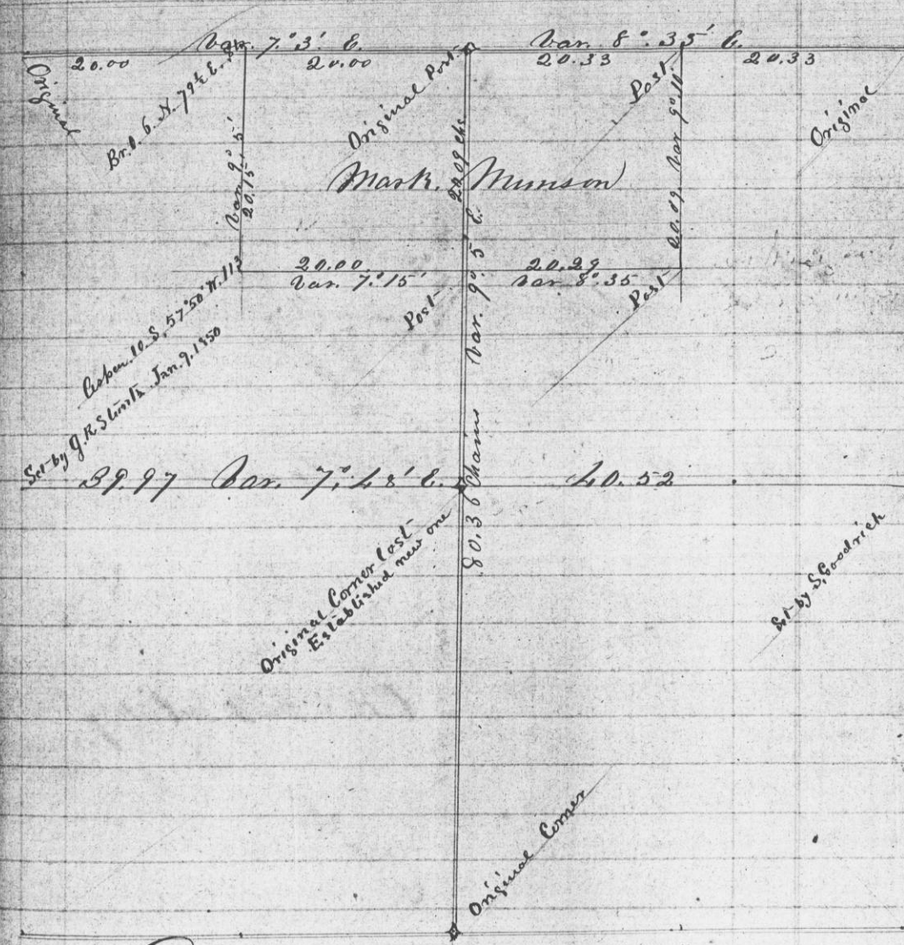

A true Copy
Attest C. Whitney Hayden
Co. Surveyor

Recorded Dec. 25 1857